
Form 51—8-18 -5M—Mid West

Map No.---------- Sec. 30 Twp. 26 R. 5

Well No. 43 Koogles Farm

Magnolia Company

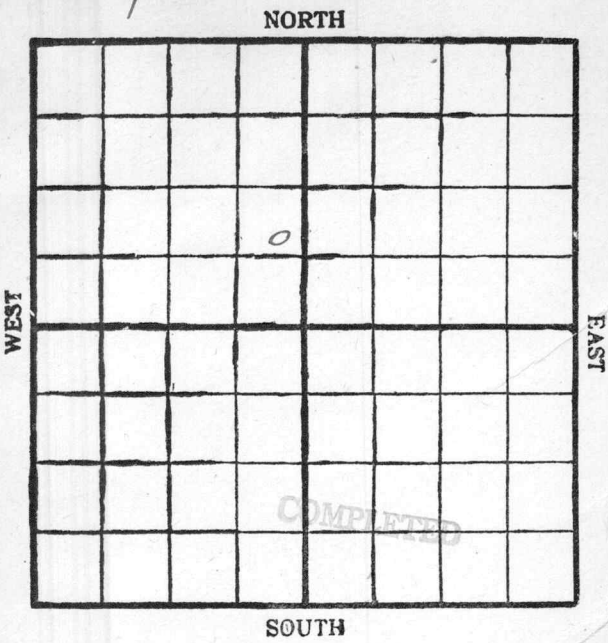

Location ----------

Drilling Remarks:

Rig Up ----------

Drilling Remarks:

RECORD

Cased---------- in.---------- ft.

Sand ----------

Gas ----------

Oil----------

Total Depth ----------

PRODUCTION

1st 24 hrs. Nat.----------

1st 24 hrs. after shot----------

Gas ---------- cu. ft.

Dry Hole ----------

Abandoned ----------


Form 26—1M Books of 100 Sheets Each—4-15-18

Map No. R14 Sec. 30 Twp. 26 R. 5

Well No. 43 Kroger

Magnolia Pet. Company

Contractor

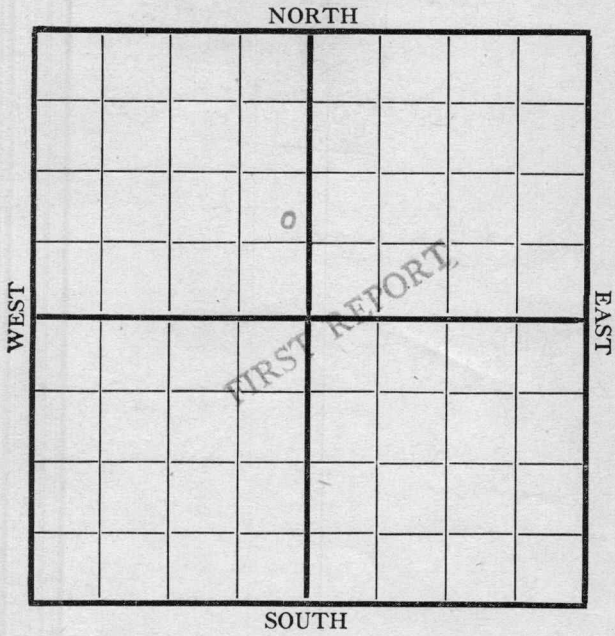

Location 350-E 947-S

Rig up ✓

Drilling and Remarks:

RECORD

Cased ____ in., ____ ft.

Sand

Gas

Oil

Total Depth

PRODUCTION

1st 24 hrs. Nat.

1st 24 hrs. after shot

Gas ____ Cu. Ft.

Dry Hole

Abandoned

Date

11/13 191 8 Doyle Scout


Form 26—M Books of 100 Sheets Each—4-15-18

Map No. K14 Sec. 30 Twp. 26 R. 5

Well No. #3 Koogler

Magnolia Company

Contractor

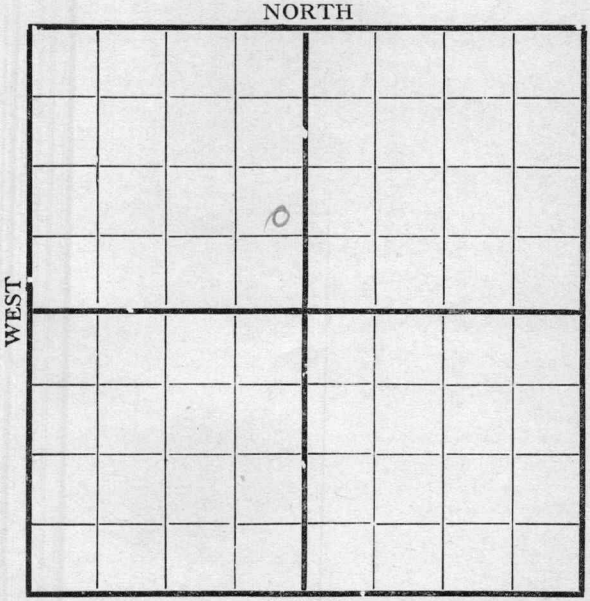

Location

Rig up ✓

Drilling and Remarks:

RECORD

Cased ____ in., ____ ft.

Sand

Gas

Oil

Total Depth

PRODUCTION

1st 24 hrs. Nat.

1st 24 hrs. after shot

Gas ____ Cu. Ft.

Dry Hole

Abandoned

Date

11/19 1918 Clyde Scout


Form 26—1M Books of 100 Sheets Each—4-15-18

Map No. K14 Sec. 30 Twp. 26 R. 5

Well No. 43 Kroger

Magnolia Pet. Company

Contractor

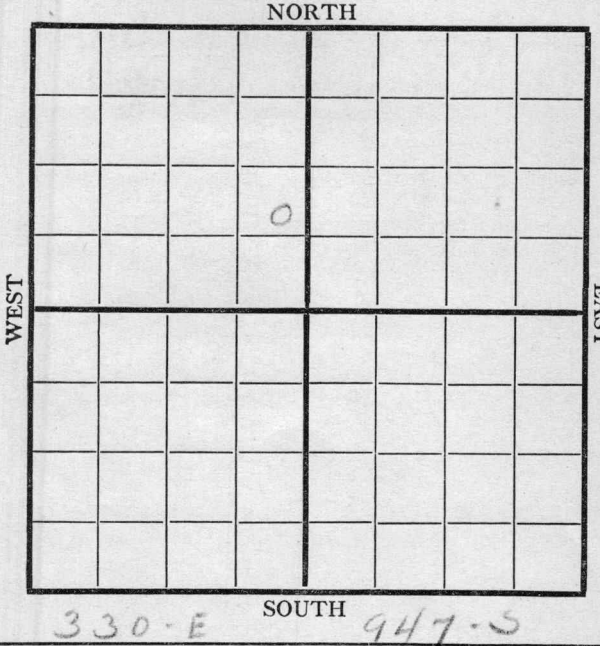

Location

Rig up ✓

Drilling and Remarks:

RECORD

Cased in., ft.

Sand

Gas

Oil

Total Depth

PRODUCTION

1st 24 hrs. Nat.

1st 24 hrs. after shot

Gas Cu. Ft.

Dry Hole

Abandoned

Date

1/29 191

Pyle Scout


Form 26—1M Books of 100 Sheets Each—4-15-18

Map No. K14 Sec. 30 Twp. 26 R. 5

Well No. 43 Koogler

Magnolia Pet- Company

Contractor

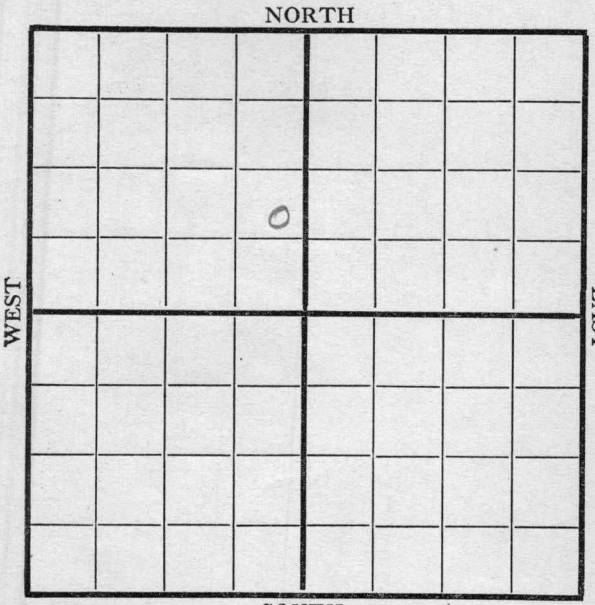

Location

Rig up

Drilling and Remarks:

305

RECORD

Cased in., ft.

Sand

Gas

Oil

Total Depth

PRODUCTION

1st 24 hrs. Nat.

1st 24 hrs. after shot

Gas Cu. Ft.

Dry Hole

Abandoned

Date

12/5 191 4 Scout


Form 26—1M Books of 100 Sheets Each—4-15-18

Map No. 4 14 Sec. 30 Twp. 26 R. 5

Well No. 4 3 Koogler

Magnolia Pet. Company

Contractor

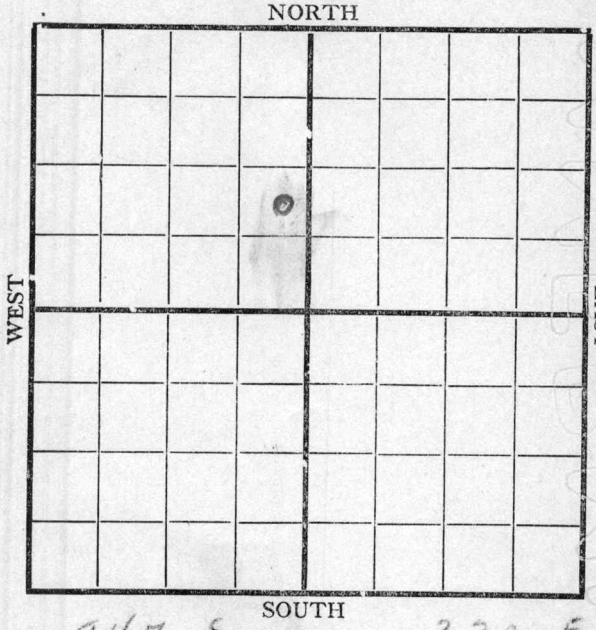

947 S 330 E

Location

Rig up

Drilling and Remarks:

420'

RECORD

Cased in., ft.

Sand

Gas

Oil

Total Depth

PRODUCTION

1st 24 hrs. Nat.

1st 24 hrs. after shot

Gas Cu. Ft.

Dry Hole

Abandoned

Date

12/12 1918

H. B. Scout


Form 26—1M Books of 100 Sheets Each—4-15-18

Map No. K 14 Sec. 30 Twp. 26 R. 5

Well No. 43 Kooglen

Magnolia Pet. Company

Contractor

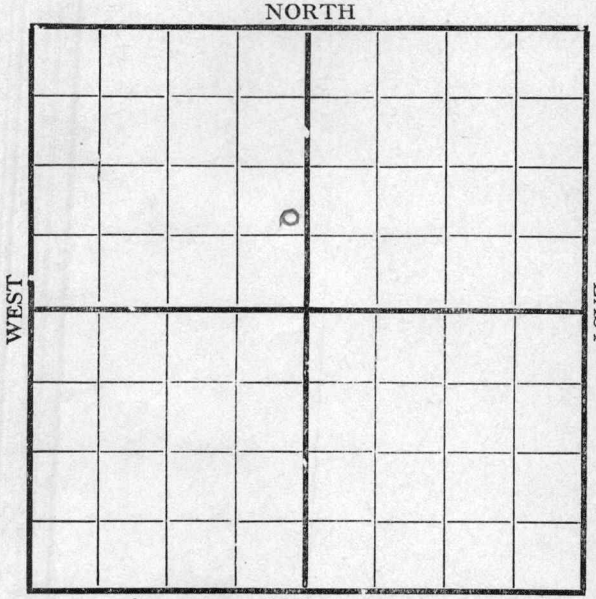

947 S 330 E

Location

Rig up

Drilling and Remarks:

760'

RECORD

Cased in., ft.

Sand

Gas

Oil

Total Depth

PRODUCTION

1st 24 hrs. Nat.

1st 24 hrs. after shot

Gas Cu. Ft.

Dry Hole

Abandoned

Date 12/18 191 8

Pyle Scout


Form 26—1M Books of 100 Sheets Each—4-15-18

Map No. T14 Sec. 30 Twp. 26 R. 5

Well No. 43 Koogler

Magnolia Pet. Company

Contractor

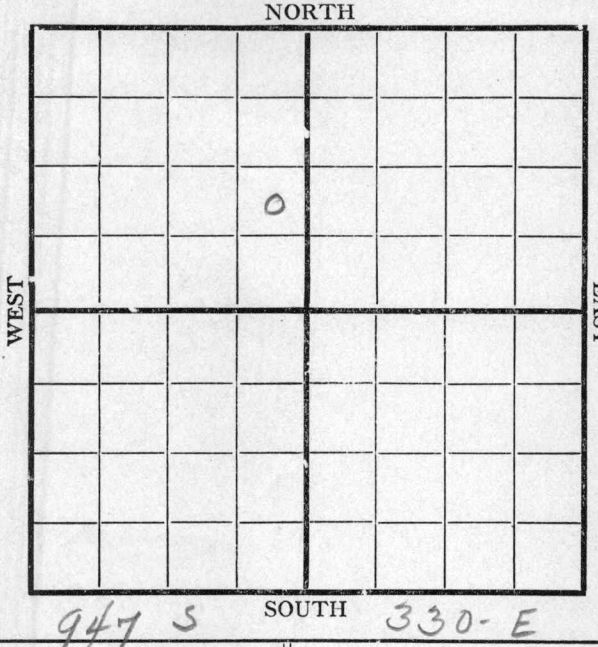

Location

Rig up

Drilling and Remarks:

D 10 @ 760'

RECORD

Cased in., ft.

Sand

Gas

Oil

Total Depth

PRODUCTION

1st 24 hrs. Nat.

1st 24 hrs. after shot

Gas Cu. Ft.

Dry Hole

Abandoned

Date

12/27 191 8

Pyle Scout


Form 26—1M Books of 100 Sheets Each—4-15-18

Map No. K14 Sec. 30 Twp. 26 R. 5

Well No. 43 Knowles

Magnolia Pet. Company

Contractor

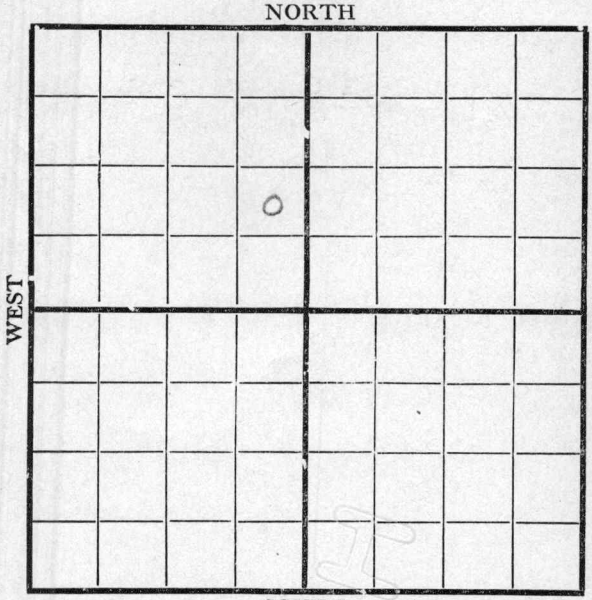

947 S 330 E

Location

Rig up

Drilling and Remarks:

9410'

RECORD

Cased in., ft.

Sand

Gas

Oil

Total Depth

PRODUCTION

1st 24 hrs. Nat.

1st 24 hrs. after shot

Gas Cu. Ft.

Dry Hole

Abandoned

Date

Jan 16 1919 Pyle Scout


Form 26—1M Books of 100 Sheets Each—4-15-18

Map No. K14 Sec. 30 Twp. 26 R. 5

Well No. 43 Kooyer

Magnolia Pet- Company

Contractor

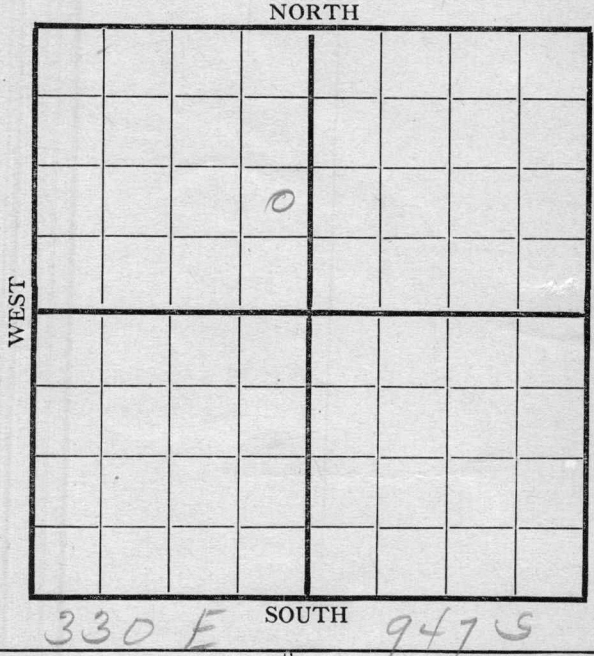

Location

Rig up

Drilling and Remarks:

1350

RECORD

Cased in., ft.

Sand

Gas

Oil

Total Depth

PRODUCTION

1st 24 hrs. Nat.

1st 24 hrs. after shot

Gas Cu. Ft.

Dry Hole

Abandoned

Date

Jan 22 1919. Pyle Scout


Form 26—1M Books of 100 Sheets Each—4-15-18

Map No. K14 Sec. 30 Twp. 26 R. 5

Well No. 43 Rogers

Magnolia Pet— Company

Contractor

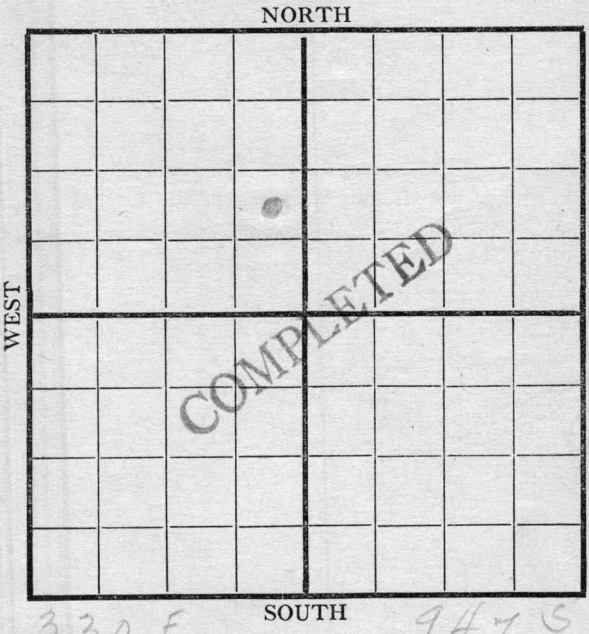

Location

Rig up

Drilling and Remarks:

RECORD

Cased in., ft.

Sand 2619 - 2629

Gas

Oil

Total Depth

PRODUCTION

1st 24 hrs. Nat. 50 bbls

1st 24 hrs. after shot

Gas Cu. Ft.

Dry Hole

Abandoned

Date

April 18 191 7

Scout