
FORM 51 25M 3-49 PETROL

Greenwood KANSAS

Section 16 Township 25 Range 9E

Well No. #1 Berrier

Company Pohamus et al

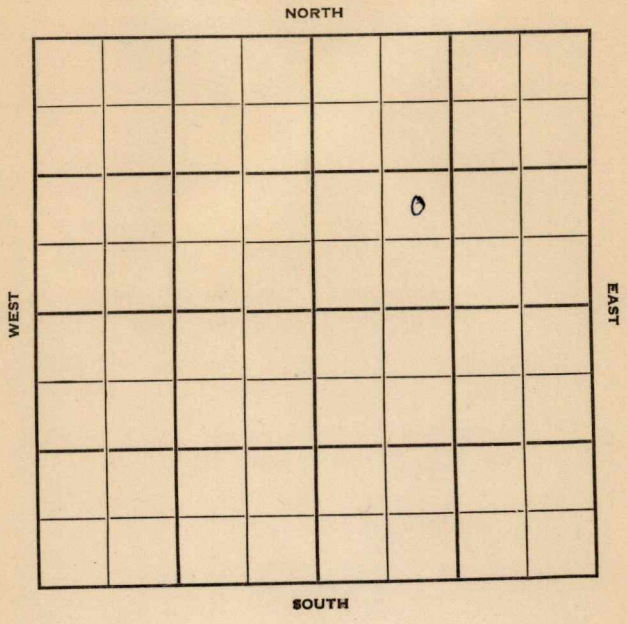

FORM 252-B
10M 9-49 PETROL

KANSAS Greenwood

Sec. 16 Twp. 25 R. 9-E

Well No. #1 Berrier Farm

Pohamus etal. Company

Contractor

Wildcat


Ft. from N. Line

990 Ft. from S. Line

Ft. from E. Line

990 Ft. from W. Line

NE SW NE

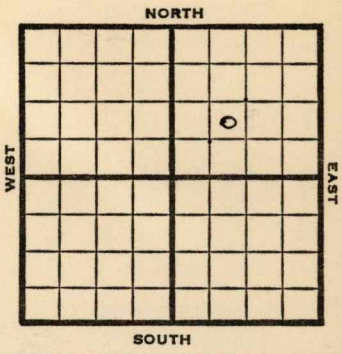

1950	REPORT
3/22	RUR
4/19	TD 2400' Bart sd 2327' D&A Aband.

ABANDONED

Form 26 200 Bks. 11-49 Petrol

Kansas Wildcat

Map No. ____ Sec. 16 Twp. 25 R. 9E


Well No. 1 Berrier

Pohamus etal. Company

Contractor

NE SW NE

SECTION PLAT

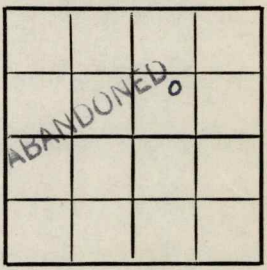

____ Ft. from N. Line

990 Ft. from S. Line

____ Ft. from E. Line

990 Ft. from W. Line

Greenwood County

Location

Rig up

Drilling and Remarks:

Bart. sd. 2327

D+A

RECORD

Cased ____ in., ____ ft.

Sand

Gas

Oil

Total Depth 2400

PRODUCTION

1st 24 hrs. Nat.

1st 24 hrs. after shot

Gas ____ Cu. Ft.

Dry Hole

Abandoned

Date

APR 19 1950 19

J. E. TYRA Scout

Form 26 200 Bks. 11-49 Petrol Kansas Wildcat

Map No. _____ Sec. 16 Twp. 25 R. 9E


Well No. 1 Berrier

Pohamus etal. Company

Contractor

NE SW NE

SECTION PLAT

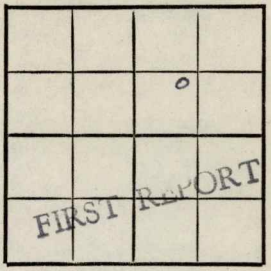

_____ Ft. from N. Line

990 Ft. from S. Line

_____ Ft. from E. Line

990 Ft. from W. Line

Greenwood County

Location _____

Rig up _____

Drilling and Remarks:

R U R

RECORD

Cased _____ in., _____ ft.

Sand _____

Gas _____

Oil _____

Total Depth _____

PRODUCTION

1st 24 hrs. Nat. _____

1st 24 hrs. after shot _____

Gas _____ Cu. Ft.

Dry Hole _____

Abandoned _____

Date

MAR 22 1950 19

J. E. TYRA Scout