


Map No. _____ Sec. 35 Twp. 26 R. 5
Well No. 10 Bisayaw Farm
Duland Oil Co. Inc. Company

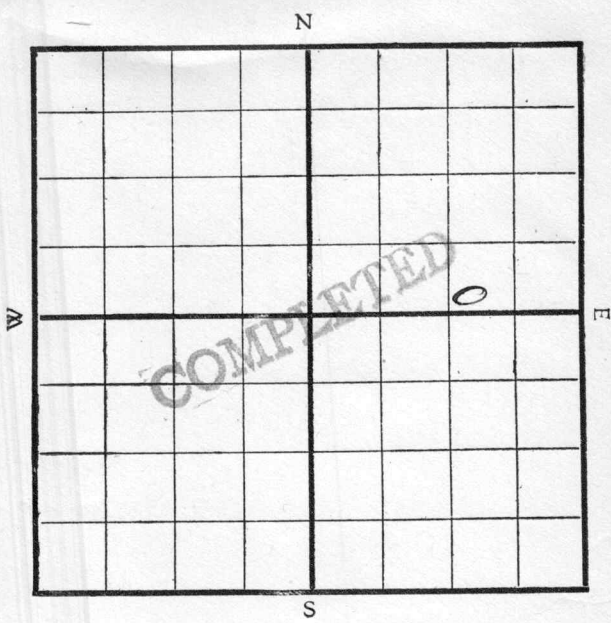

Location _____
Drilling Remarks:

Rig Up _____
Drilling Remarks:

RECORD

Cased _____ in. _____ ft.
Sand _____
Gas _____
Oil _____
Total Depth _____

PRODUCTION

1st 24 hrs. Nat. _____
1st 24 hrs. after shot _____
Gas _____ cu. ft.
Dry Hole _____
Abandoned _____

Map No. _____ Sec. 35 Twp. 26 R. 5

Well No. 10. Bisaguo Farm
Island Oil Co Ltd Company


Contractor W.E. Quarter

_____ Ft. from N. Line

200 Ft. from S. Line

1120 Ft. from E. Line

_____ Ft. from W. Line

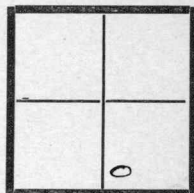

10/19

REPORT

10/1 Rig up
3/4 2651' - 2709' 67150

Map No. K14 Sec. 35 Twp. 26 R. 5

Well No. 10 Bisagna
Inland Oil & Gas Company

Contractor

SECTION PLAT

_____ Ft. from N. Line

_____ Ft. from S. Line

_____ Ft. from E. Line

_____ Ft. from W. Line

COMPLETED

Location _____

Rig up _____

Drilling and Remarks:

Shot 60 gto

RECORD

Cased _____ in., _____ ft.

Sand 2651-2709

Gas _____

Oil _____

Total Depth _____

PRODUCTION

1st 24 hrs. Nat. _____

1st 24 hrs. after shot 150 bbl

Gas _____ Cu. Ft.

Dry Hole _____

Abandoned _____

Date

Pyle

3/4 1920

Scout

Map No. K14 Sec. 35 Twp. 26 R. 5Well No. 10 BisagnaInland Oil & Gas Company

Contractor

SECTION PLAT

Ft. from N. Line

200 Ft. from S. Line1120 Ft. from E. Line

Ft. from W. Line

Location

Rig up ☒

Drilling and Remarks:

RECORD

Cased _____ in., _____ ft.

Sand _____

Gas _____

Oil _____

Total Depth _____

PRODUCTION

1st 24 hrs. Nat. _____

1st 24 hrs. after shot _____

Gas _____ Cu. Ft.

Dry Hole _____

Abandoned _____

Date

11/1 1919

Pyle

Scout