


Map No. KANSAS Sec. 24 Twp. 27 R. 1E

Well No. 1- Brerner Farm
Douglas Ave Oil Corp Company

NORTH

WEST

EAST

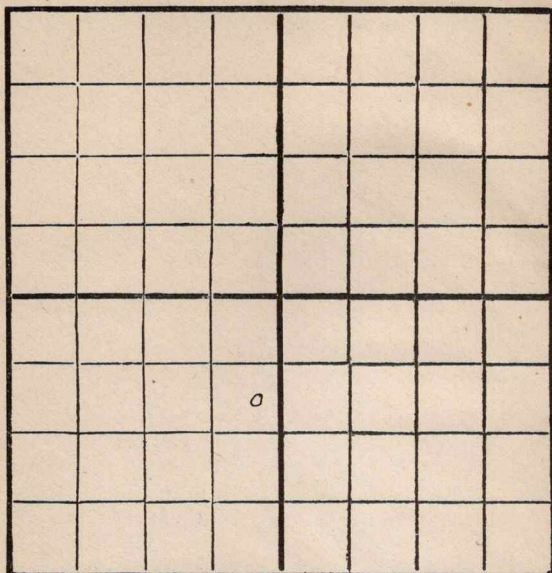

SOUTH

Location _____

Drilling Remarks

Rig Up _____

Drilling Remarks

RECORD

Cased _____ in. _____ ft.

Sand _____

Gas _____

Oil _____

Total Depth _____

PRODUCTION

1st 24 hrs. Nat. _____

1st 24 hrs. after shot _____

Gas _____ cu. ft.

Dry Hole _____


Abandoned _____

Sedgwick 5-173-01949
 Map No. *141* **NSAS** Sec. *24* Twp. *27* R. *1E*
 Well No. *1- Bruner* Farm
Douglas Roe Oil Company

NORTH

WEST

EAST

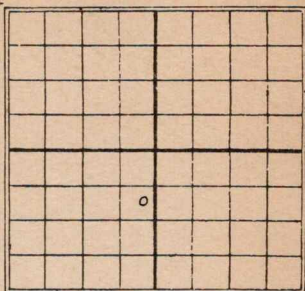

SOUTH

980 Ft. from N. Line

_____ Ft. from S. Line

162 Ft. from E. Line

_____ Ft. from W. Line

1930

Date

REPORT

<i>10/1</i>	<i>Reg</i>
<i>10/8</i>	<i>ft</i>
<i>10/15</i>	<i>Spud & 5.D.</i>
<i>10/22</i>	<i>—</i>
<i>10/29</i>	<i>—</i>
<i>11/5</i>	<i>—</i>
<i>11/12</i>	<i>—</i>
<i>11/19</i>	<i>—</i>
<i>11/25</i>	<i>—</i>
<i>12/3</i>	<i>—</i>
<i>12/10</i>	<i>—</i>
<i>12/17</i>	<i>—</i>
<i>12/23</i>	<i>—</i>
<i>12/30</i>	<i>—</i>
<i>1931</i>	
<i>1/7</i>	<i>—</i>
<i>1/14</i>	<i>Abandon loc</i>

Map No. KANSAS Sec. 24 Twp. 27 R. 16

Well No. 1 Bruner

Douglas Core Oil Co. Company
Contractor

SECTION PLAT

980 Ft. from N. Line

_____ Ft. from S. Line

162 Ft. from E. Line

_____ Ft. from W. Line

FIRST REPORTS

Location _____

Rig up _____

Drilling and Remarks:

Rig

RECORD

Cased _____ in., _____ ft.

Sand _____

Gas _____

Oil _____

Total Depth _____

PRODUCTION

1st 24 hrs. Nat. _____

1st 24 hrs. after shot _____

Gas _____ Cu. Ft.

Dry Hole _____

Abandoned _____

Date

OCT 1 1930

S. J. LEWIS Scout

Bedgwick
 Map No. **KANSAS** Sec. *24* Twp. *27* R. *1E*

12
 Well No. *1 Bruner*

Douglas Core Oil Corp Company

Contractor

SECTION PLAT

980 Ft. from N. Line

Ft. from S. Line

162 Ft. from E. Line

Ft. from W. Line

ABANDONED

Location

Rig up

Drilling and Remarks:

Spud.

RECORD

Cased in., ft.

Sand

Gas

Oil

Total Depth *Loc*

PRODUCTION

1st 24 hrs. Nat.

1st 24 hrs. after shot

Gas Cu. Ft.

Dry Hole

Abandoned *Loc*

Date

JAN 14 1931
 192

S. J. LEWIS Scout