

Greenwood

Form 51-5M-9-28-27423

Map No. **KANSAS** Sec. *17* Twp. *25* R. *9*

Well No. *1- Hendrickson* Farm
D. H. Morgan Company

NORTH

WEST

EAST

		0					

SOUTH

Location.....
 Drilling Remarks

Rig Up.....
 Drilling Remarks

RECORD

Cased..... in..... ft.
 Sand.....
 Gas.....
 Oil.....
 Total Depth.....

PRODUCTION

1st 24 hrs. Nat.....
 1st 24 hrs. after shot.....
 Gas..... cu. ft.....
 Dry Hole.....
 Abandoned.....

Map No. **KANSAS** Sec. 17 Twp. 25 R. 9


Well No. 1 - Hendrickson Farm
J. H. Morgan Company

_____ Ft. from N. Line

660 Ft. from S. Line

_____ Ft. from E. Line

1120 Ft. from W. Line

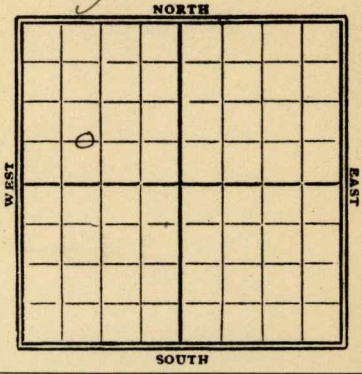

1929

Date

REPORT

1/30	Machine
2/16	Rig
2/13	Drill 1200'
2/20	" 1200'
3/6	" 1925'
3/13	Top sand, 2325' - 6" S.D. for title.
3/20	3 bbl show 2320-25' T.D. 2376' Dry & abandoned

X15 **KANSAS** Greenwood
Map No. Sec. 17 Twp. 25 R. 9

Well No. 1 Hendrickson

D.H. Morgan Company

Contractor

FIRST REPORTS

..... Ft. from N. Line

660 Ft. from S. Line

..... Ft. from E. Line

1120 Ft. from W. Line

SECTION PLAT

o			

Location Machine

Rig up

Drilling and Remarks:

Formerly
Derby Oil Co.

RECORD

Cased.....in.,ft.

Sand.....

Gas.....

Oil.....

Total Depth.....

PRODUCTION

1st 24 hrs. Nat.....

1st 24 hrs. after shot.....

Gas.....Cu. Ft.

Dry Hole.....

Abandoned.....

Date

JAN 30 1929

CHAS. L. SHERWOOD

192.....

Scout

Sherwood

Map No. **KANSAS** Sec. *17* Twp. *75* R. *9*

Well No. *1 Henderson*

D. H. Morgan Company

Contractor

COMPLETE

SECTION PLAT

..... Ft. from N. Line

660 Ft. from S. Line

..... Ft. from E. Line

1120 Ft. from W. Line

o			

ABANDONED

Location.....

Rig up.....

Drilling and Remarks:

*3 Bl Show
7320-75*

D. H. Morgan

RECORD

Cased..... in., ft.

Sand.....

Gas.....

Oil.....

Total Depth *2376'*

PRODUCTION

1st 24 hrs. Nat.....

1st 24 hrs. after shot.....

Gas..... Cu. Ft.

Dry Hole

Abandoned

Date

MAR 20 1929

CHAS. L. SHERWOOD

..... 192.....

..... Scout