


Map No. K Sec. 17 Twp. 25 R. 9
Well No. 6 Ladd Farm
 Hayes & Roberts Company

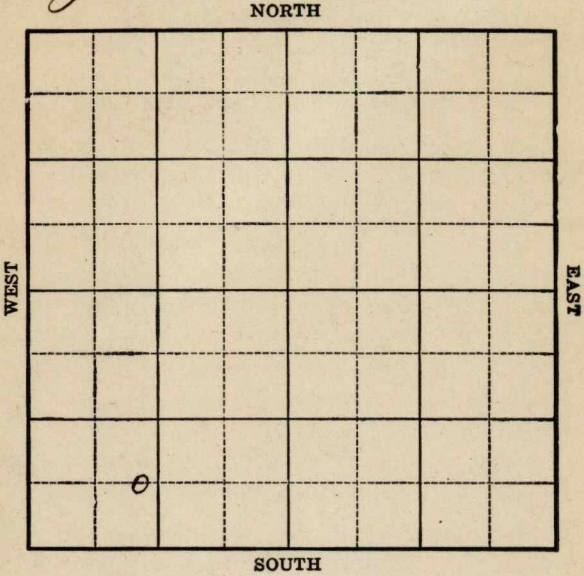

Location _____

Drilling Remarks:

RECORD

Cased _____ in. _____ ft.

Sand _____

Gas _____

Oil _____

Total Depth _____

Rig Up _____

Drilling Remarks:

PRODUCTION

1st 24 hrs. Nat. _____

1st 24 hrs. after shot _____

Gas _____ cu. ft.

Dry Hole _____


Abandoned _____

Map No. 11 Sec. 17 Twp. 25 R. 9Well No. 6. Ladd Farm
Hanges & Roberts Company

Ft. from N. Line

660 Ft. from S. Line

Ft. from E. Line

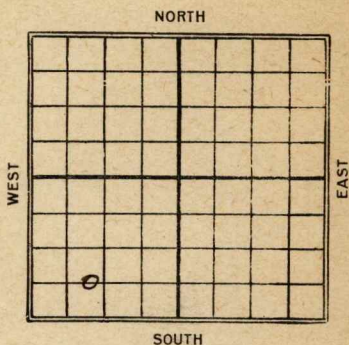1120 Ft. from W. Line

REPORT

Date

9/9 Rgn up

10/8 Sand 2362 - 2431

T.D. 2460' D. + G.

Map No. 15 **KANSAS** Sec. 17 Twp. 25 R. 9

Well No. # 6 Ladd
Hayes & Roberts Company

Contractor

FIRST REPORT

SECTION PLAT

_____ Ft. from N. Line

660 Ft. from S. Line

_____ Ft. from E. Line

1120 Ft. from W. Line

Location _____

Rig up _____

Drilling and Remarks:

Rig up

RECORD

Cased _____ in., _____ ft.

Sand _____

Gas _____

Oil _____

Total Depth _____

PRODUCTION

1st 24 hrs. Nat. _____

1st 24 hrs. after shot _____

Gas _____ Cu. Ft.

Dry Hole _____

Abandoned _____

Date

SEP 9 1924

192

M. A. BENEAR

Scout

155 KANSAS Map No. _____ Sec. 17 Twp. 25 R. 9

Well No. 6 - Ladd
Hayes & Roberts Company

Contractor

ABANDONED

SECTION PLAT

0			

_____ Ft. from N. Line

660 _____ Ft. from S. Line

_____ Ft. from E. Line

1120 _____ Ft. from W. Line

Location _____

Rig up _____

Drilling and Remarks:

sand 2362-2431

J.D. 2460

L.O. & A.

RECORD

Cased _____ in., _____ ft.

Sand _____

Gas _____

Oil _____

Total Depth _____

PRODUCTION

1st 24 hrs. Nat. _____

1st 24 hrs. after shot _____

Gas _____ Cu. Ft.

Dry Hole _____

Abandoned _____

Date

OCT 8 1924

192

M. A. BENEAR

Scout