


DX 78-1 Greenwood

KANSAS

Section 17 Township 25 Range 9E

Well No. 7 **Spencer**

Company Deering Marshall

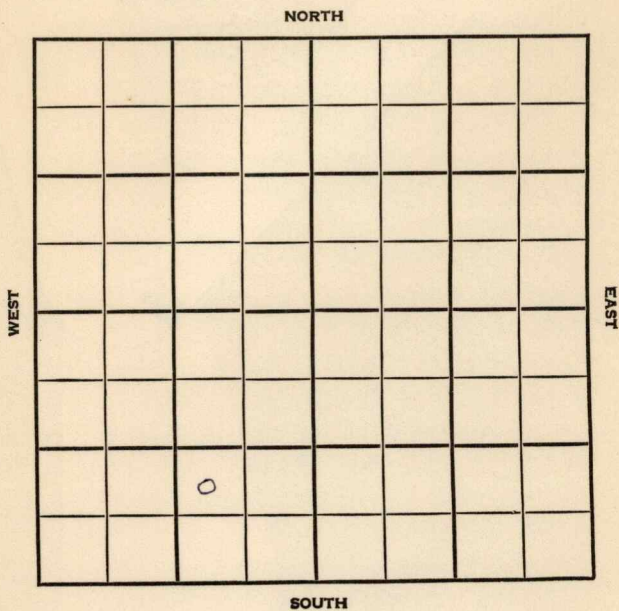

Greenwood KANSAS

SEC.	TWP.	R.
17	25	9E

WELL NO.

7 Spencer

FARM

COMPANY

Deering Marshall

CONTRACTOR


Bedell & Catt
Sallyards Pool

_____ Ft. from N. Line

990 _____ Ft. from S. Line

990 _____ Ft. from E. Line

_____ Ft. from W. Line

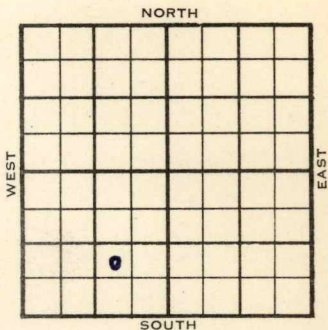

NW SE SW

ELEVATION

REPORT

1955

4/27

Spud 2-11-55
8" @ 72'
TD 2425'
4" @ 2380'

