


DX 78-1 Greenwood

KANSAS

Section 17 Township 25 Range 9E

Well No. 8 Spencer

Company Deering Marshall

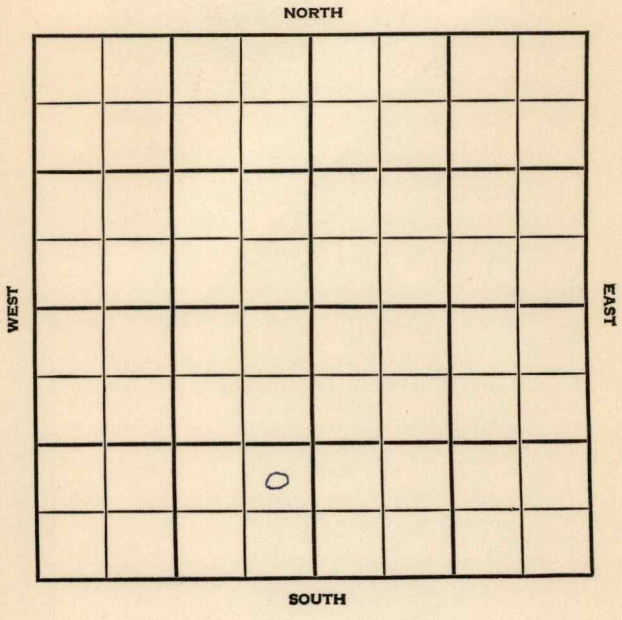

SEC.	TWP.	R.
17	25	9E

WELL NO. 8 Spencer FARM

COMPANY Deering Marshall

CONTRACTOR Bedell & Catt

Sallyards Pool


_____ Ft. from N. Line

990 _____ Ft. from S. Line

330 _____ Ft. from E. Line

_____ Ft. from W. Line

NE SE SW

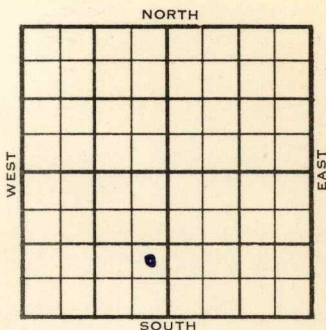

	ELEVATION	REPORT
--	-----------	--------

1955

4/27

Spud 2-21-55
 8" @ 64'
 TD 2435'
 4" @ 2390'

