


Section 17 Township 25 Range 9E

Well No. 9 Spencer

Company Derring Marshall;

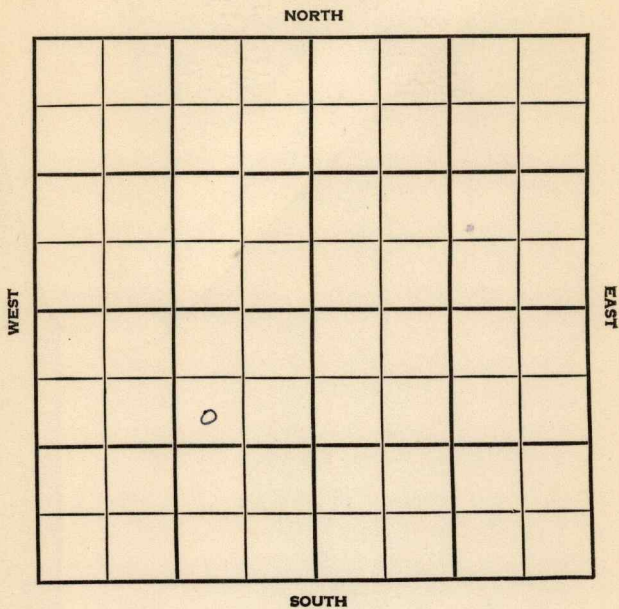


**Greenwood KANSAS**

SEC.	TWP.	R.
17	25	9E

WELL NO. \_\_\_\_\_  
 COMPANY 9 Spencer FARM

CONTRACTOR Deering Marshall  
Bedell & Catt

990 \_\_\_\_\_ Ft. from N. Line  
 \_\_\_\_\_ Ft. from S. Line  
990 \_\_\_\_\_ Ft. from E. Line  
 \_\_\_\_\_ Ft. from W. Line

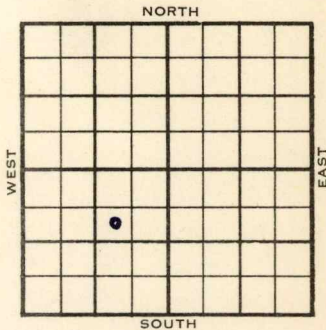

SW NE SW

1955	ELEVATION <b>1334</b>	REPORT
------	--------------------------	--------

4/27 Setting Surface  
 6/29 Comm 4-26-55  
KC 1703  
BKC Bart 2390-2420  
TD 2427  
8 5/8" @ 65/50  
5 1/2" @ 2391/100  
CO to 2427 frac  
Comp 15 bopd

**COMPLETED**

County Greenwood State Kansas

Sec. 17 (Blk. Twp.) 25 (Sur. Rge.) 9E Map No.

Operator Deering Marshall

Well No. 9 Farm Spencer

Elev. \_\_\_\_\_ Location SW NE SW


FIRST REPORT

0

990 Ft. From N Line SW

990 Ft. From E Line Quarter

1st. Report APR 27 1955

Completion \_\_\_\_\_

Remarks \_\_\_\_\_

Bedell & Catt - Contr.

Spudding Date \_\_\_\_\_

Drlg. Data \_\_\_\_\_

setting surface

County Greenwood Elev. 1334 RB  
 Sec. 17 Twp. 25 Rge. 9E  
 Company Deering Marshall  
 Farm Name Spencer No. 9

TOPS	DEPTH	LOG	DATUM
Anh.			
Tr.			
H.			
Tr.			
Dg.			
Bl.			
L.			
K.C.	<u>1703</u>		<u>.369</u>
B.K.C. <u>Bart</u>	<u>2390-2420</u>		<u>1086</u>
Ce.			
C.			
M.			
M.			
K.			
Mz.			
Me.			
V.			
S.			
S.			
A			
R.			
PE.			
G.			
T.D.	<u>2427</u>		

Loc. in Sec. SW NE SW  
 Geol. \_\_\_\_\_  
 Contr. Bedell & Cat  
 Pool \_\_\_\_\_

<b>COMPLETE</b>		

Date Comm. 4-26-55 JUN 29 1955

8 5/8" @ 65/50 5 1/2" @ 2391/100  
CO to 2427 frac Comp. 15 bopd

Co. No. Sec. T. R.