


Map No. 1 Sec. 32 Twp. 26 R. 6Well No. 1 Palmer FarmFonaker etal Company

NORTH

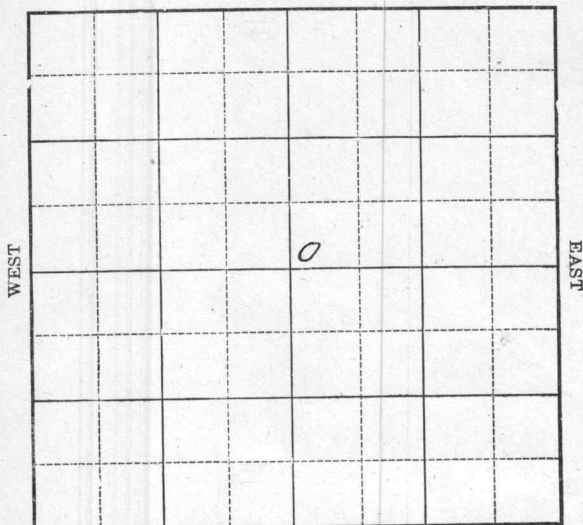

SOUTH

Location _____

Drilling Remarks:

Rig Up _____

Drilling Remarks:

RECORD

Cased _____ in. _____ ft.

Sand _____

Gas _____

Oil _____

Total Depth _____

PRODUCTION

1st 24 hrs. Nat. _____

1st 24 hrs. after shot _____

Gas _____ cu. ft.

Dry Hole _____

Abandoned _____

Map No. KANSAS 14 Sec. 32 Twp. 26 R. 6

Well No. 1 Palmer

Foraker et al Company

Contractor

FIRST REPORT

SECTION PLAT

200 Ft. from N. Line

_____ Ft. from S. Line

1120 Ft. from E. Line

_____ Ft. from W. Line

			o

Location _____

Rig up ✓ _____

Drilling and Remarks:

RECORD

Cased _____ in., _____ ft.

Sand _____

Gas _____

Oil _____

Total Depth _____

PRODUCTION

1st 24 hrs. Nat. _____

1st 24 hrs. after shot _____

Gas _____ Cu. Ft.

Dry Hole _____

Abandoned _____

Date

JAN 6 1923

M. A. BENEAR

191

Scout

K 14. 32 26 6
Map No. _____ Sec. _____ Twp. _____ R. _____Well No. 1-Palmer
Faraker Company_____
Contractor

SECTION PLAT

_____ Ft. from N. Line

200 Ft. from S. Line

_____ Ft. from E. Line

200 Ft. from W. Line

		o	

Location _____

Rig up ✓✓ _____

Drilling and Remarks:

RECORD

Cased _____ in., _____ ft.

Sand _____

Gas _____

Oil _____

Total Depth _____

PRODUCTION

1st 24 hrs. Nat. _____

1st 24 hrs. after shot _____

Gas _____ Cu. Ft.

Dry Hole _____

Abandoned _____

Date _____

Map No. _____ Sec. 32 Twp. 26 R. 6Well No. 1 - PalmerForaker et al. Company_____
Charged Lab. Contractor

SECTION PLAT

200 Ft. from N. Line_____
Ft. from S. Line_____
Ft. from E. Line_____
Ft. from W. Line

Location _____

Rig up ✓✓

Drilling and Remarks:

RECORD

Cased _____ in., _____ ft.

Sand _____

Gas _____

Oil _____

Total Depth _____

PRODUCTION

1st 24 hrs. Nat. _____

1st 24 hrs. after shot _____

Gas _____ Cu. Ft.

Dry Hole _____

Abandoned _____

Date

192 _____ Scout

Map No. **KANSAS** Sec. **32** Twp. **26** R. **6**

Well No. **1 Palmer**
Leighton + Gilkies Company

Contractor

FIRST REPORT

SECTION PLAT

200 Ft. from N. Line

_____ Ft. from S. Line

1120 Ft. from E. Line

_____ Ft. from W. Line

Location _____

Rig up **V V**

Drilling and Remarks:

RECORD

Cased _____ in. _____ ft.

Sand _____

Gas _____

Oil _____

Total Depth _____

PRODUCTION

1st 24 hrs. Nat. _____

1st 24 hrs. after shot _____

Gas _____ Cu. Ft.

Dry Hole _____

Abandoned _____

Date

JUN 10 1923

M. A. BENEAR

192

Scout

14 **KANSAS** Map No. _____ Sec. 32 Twp. 26 R. 6^E

Well No. #1 Palmer _____

Faraker et al _____ Company

_____ Contractor


ABANDONED SECTION PLAT

_____ Ft. from N. Line

200 _____ Ft. from S. Line

_____ Ft. from E. Line

200 _____ Ft. from W. Line

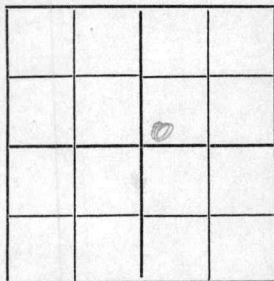

Location _____

Rig up _____

Drilling and Remarks:

Rig & Loc.
abandoned,

RECORD

Cased _____ in., _____ ft.

Sand _____

Gas _____

Oil _____

Total Depth _____

PRODUCTION

1st 24 hrs. Nat. _____

1st 24 hrs. after shot _____

Gas _____ Cu. Ft.

Dry Hole _____

Abandoned _____

Date

NOV 28 1924

M. A. BENEAR

_____ 192 _____

_____ Scout