
Form 51 5M 7-22 9573

Map No. _____ Sec. 5 Twp. 23 R. 11

Well No. 7 Seely Farm

Johnson & Vickers Company

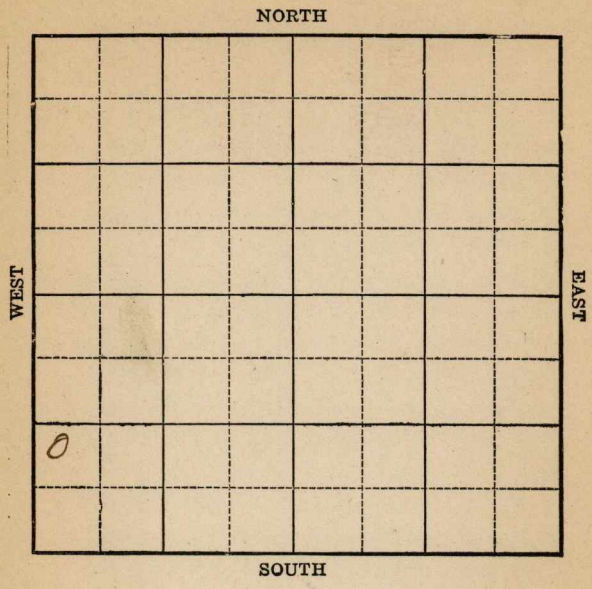

Location _____

Drilling Remarks:

Rig up _____

Drilling Remarks:

RECORD

Cased _____ in. _____ ft.

Sand _____

Gas _____

Oil _____

Total Depth _____

PRODUCTION

1st 24 hrs Nat. _____

1st 24 hrs. after shot _____

Gas _____ cu. ft.

Dry Hole _____

Abandoned _____

Form 252A 8M-11-20 PALACE-TULSA 4617

Map No. _____ Sec. 5 Twp. 23 R. 11

Well No. 7 Seely Farm

Johnson & Vickers Company


NORTH

_____ Ft. from N. Line

990 Ft. from S. Line

_____ Ft. from E. Line

330 Ft. from W. Line

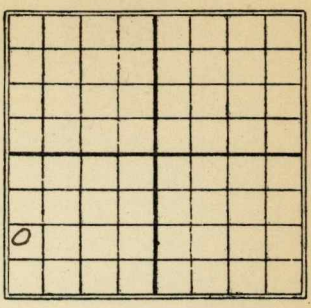

Date	REPORT
1923	
3/2	Location.
6/10	Sand 1939-97-Shot 150 qts. 120 Bbls.

Form 26—1M—4-19—Mid-West

Map No. KANSAS 16 Sec. 5 Twp. 23 R. 11


Well No. 7 Seely

Johnson & Vickers Company

_____ Contractor

FIRST REPORT

SECTION PLAT

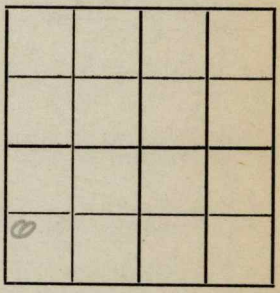

_____ Ft. from N. Line

990 Ft. from S. Line

_____ Ft. from E. Line

330 Ft. from W. Line

Location ~ ~

Rig up _____

Drilling and Remarks:

RECORD

Cased _____ in., _____ ft.

Sand _____

Gas _____

Oil _____

Total Depth _____

PRODUCTION

1st 24 hrs. Nat. _____

1st 24 hrs. after shot _____

Gas _____ Cu. Ft.

Dry Hole _____

Abandoned _____

Date

MAR 2 1923

_____ 191_____.

M. A. BENEAR

_____ Scout

Form 26—1M Bks.—3-23

Map No. KANSAS 16 Sec. 5 Twp. 23 R. 11


Well No. 7- Seely


Contractor

COMPLETED

SECTION PLAT

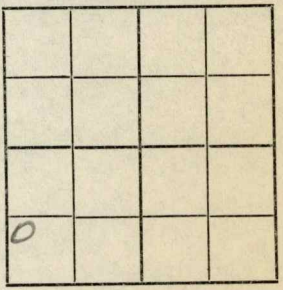

_____Ft. from N. Line

990 Ft. from S. Line

_____Ft. from E. Line

330 Ft. from W. Line

Location _____

Rig up _____

Drilling and Remarks:

sand 1939
1997

50/120 Hk

RECORD

Cased _____in., _____ ft.

Sand _____

Gas _____

Oil _____

Total Depth _____

PRODUCTION

1st 24 hrs. Nat. _____

1st 24 hrs. after shot _____

Gas _____Cu. Ft.

Dry Hole _____

Abandoned _____

Date

JUN 10 1923

_____192___.

M. A. BENEAR

_____Scout