
Form 51 5M 7-22 9573

Map No. _____ Sec. 5 Twp. 23 R. 11

Well No. 8 Deely Farm

Johnson & Vickers Company

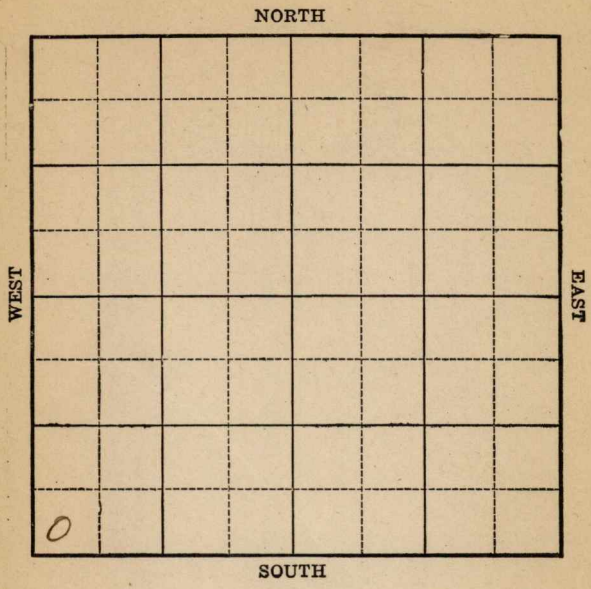

Location _____

Drilling Remarks:

Rig up _____

Drilling Remarks:

RECORD

Cased _____ in. _____ ft.

Sand _____

Gas _____

Oil _____

Total Depth _____

PRODUCTION

1st 24 hrs Nat. _____

1st 24 hrs. after shot _____

Gas _____ cu. ft.

Dry Hole _____

Abandoned _____

Form 252A 8M-11-20 PALACE-TULSA 4617

Map No. _____ Sec. 5 Twp. 23 R. 11

Well No. 8 Seely Farm

Johnson & Vickers Company


NORTH

_____ Ft. from N. Line

330 Ft. from S. Line

_____ Ft. from E. Line

330 Ft. from W. Line

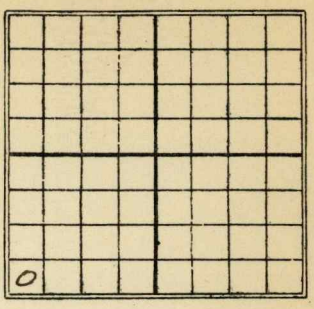

Date	REPORT
1923	
3/2	Jenkins.
6/10	Sand 1936-97- Shot 150 qts. 175 Bbls.

Form 26—1M—4-19—Mid-West

Map No. KANSAS 16 Sec. 5 Twp. 23 R. 11


Well No. 2 Seely

Johnson & Wilkins Company

Contractor

FIRST REPORT

SECTION PLAT

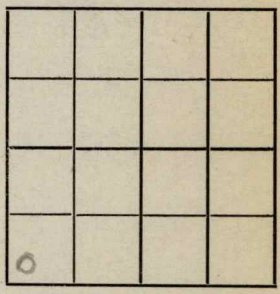

330 Ft. from N. Line

330 Ft. from S. Line

Ft. from E. Line

330 Ft. from W. Line

Location

Rig up

Drilling and Remarks:

Timbers

RECORD

Cased in., ft.

Sand

Gas

Oil

Total Depth

PRODUCTION

1st 24 hrs. Nat.

1st 24 hrs. after shot

Gas Cu. Ft.

Dry Hole

Abandoned

Date

MAR 2 1923 191

M. A. BENEAR Scout

Map No. KANSAS 16 Sec. 5 Twp. 23 R. 11


Well No. 8 Seely

Johnson & Vickers Company

Contractor

COMPLETED

SECTION PLAT

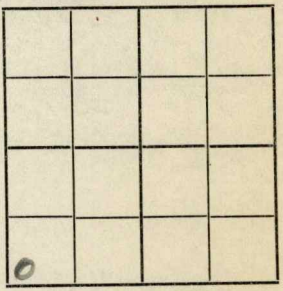

330 Ft. from N. Line

330 Ft. from S. Line

Ft. from E. Line

330 Ft. from W. Line

Location

Rig up

Drilling and Remarks:

sand {1936 1997

150/175 Hld

RECORD

Cased in., ft.

Sand

Gas

Oil

Total Depth

PRODUCTION

1st 24 hrs. Nat.

1st 24 hrs. after shot

Gas Cu. Ft.

Dry Hole

Abandoned

Date

JUN 10 1923 192

M. A. BENEAR Scout