
Form 51 5M 8-24 16567

Map No. Kansas Sec. 5 Twp. 23 R. 11

Well No. 12 Seely Farm

Phillips Pet Company

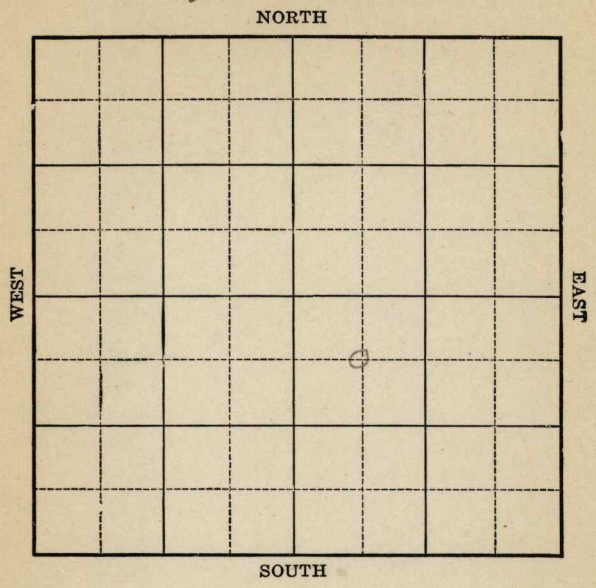

Location

Drilling Remarks

Rig Up

Drilling Remarks

RECORD

Cased in. ft.

Sand

Gas

Oil

Total Depth

PRODUCTION

1st 24 hrs. Nat.

1st. 24 hrs. after shot

Gas cu. ft.

Dry Hole

Abandoned

Form 252A 5M 8-24 16529

Map No. Kansas Sec. 5 Twp. 23 R 11

Well No. 12 Seely Farm


Phillips Pet Company

660 Ft. from N. Line

Ft. from S. Line

Ft. from E. Line

660 Ft. from W. Line

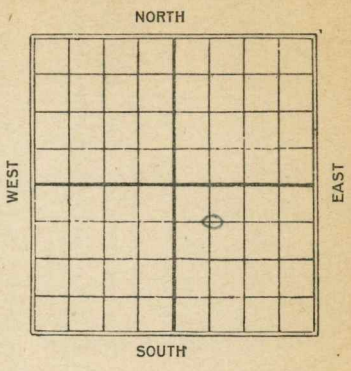

Date 1925	REPORT
3/1	Rig up
3/30	1610-34 T.D. 1641
	100 qts 8 Bbls

Form 26—1M Bks.—3-23—11959.

Map No. KANSAS Sec. 5 Twp. 23 R. 11

Well No. 12 Seely

Phillips Pet. Company

Contractor

FIRST REPORT

Twin Well


660 Ft. from N. Line

Ft. from S. Line

Ft. from E. Line

660 Ft. from W. Line

SECTION PLAT

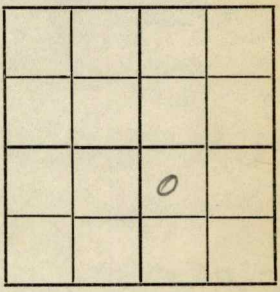

Location

Rig up

Drilling and Remarks:

RECORD

Cased in., ft.

Sand

Gas

Oil

Total Depth

PRODUCTION

1st 24 hrs. Nat.

1st 24 hrs. after shot

Gas Cu. Ft.

Dry Hole

Abandoned

Date

3/1 192 5

M. A. RENFAR Scout

Form 26—1M Bks.—3-23—11959.

Map No. 16 KANSAS Sec. 5 Twp. 23 R. 11


Well No. 12 Seely

Phillips Pet Company

Contractor

COMPLETED

SECTION PLAT

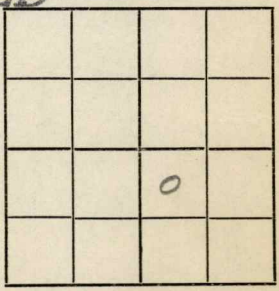

660 Ft. from N. Line

Ft. from S. Line

Ft. from E. Line

660 Ft. from W. Line

Location

Rig up

Drilling and Remarks:

100 qts shot.

RECORD

Cased in., ft.

Sand 1610 - 34

Gas

Oil

Total Depth 1641

PRODUCTION

1st 24 hrs. Nat.

1st 24 hrs. after shot 2

Gas Cu. Ft.

Dry Hole

Abandoned

Date

3/31 1925

M. A. BENEAR Scout