

KANSAS

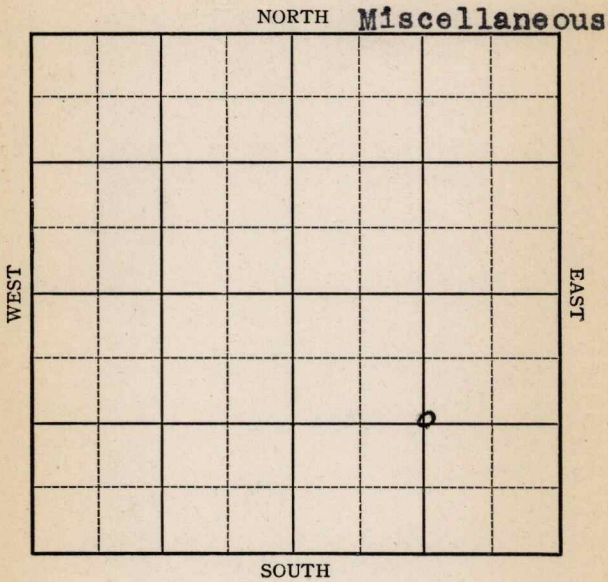
FORM 51 5M 4-41 PETROL

Greenwood

Section 5 Township 23 Range 11-E

Well No. #13 Seely "C"

Company Sinclair Prairie



1941

7/16

Bart. 1947'

5" - 1949'

T.D. 2015'

P.B. to 2008'

Shot 50 qts. 1974-2008'

Pump 8 oil

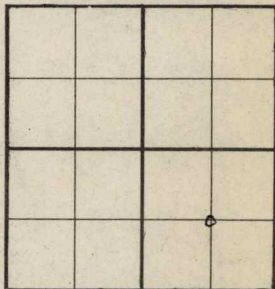
39 . Gravity

COMPLETED

Map No. 15 Sec. 5 Twp. 23 R. 9EWell No. 13 Seely "C"Sinclair Prairie Company**FIRST REPORT**

Contractor

C SE

 Ft. from N. Line1320 Ft. from S. Line1320 Ft. from E. Line Ft. from W. Line**MISCELLANEOUS****SECTION PLAT**Location XRig up

Drilling and Remarks:

RECORDCased in., ft.Sand Gas Oil Total Depth **PRODUCTION**1st 24 hrs. Nat. 1st 24 hrs. after shot Gas Cu. Ft.Dry Hole Abandoned

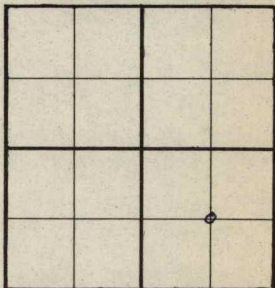
Date

APR 23 1941

19

S. J. LEWIS

Scout

Map No. 16 Sec. 5 Twp. 23 R. 11EWell No. 13 Seely "C"Sinclair Prairie CompanyCorrection Contractor**SECTION PLAT**

C SE

 Ft. from N. Line1320 Ft. from S. Line1320 Ft. from E. Line Ft. from W. Line**MISCELLANEOUS**Location Rig up Drilling and Remarks: Reported

5-23-9E

RECORDCased in., ft.Sand Gas Oil Total Depth **PRODUCTION**1st 24 hrs. Nat. 1st 24 hrs. after shot Gas Cu. Ft.Dry Hole Abandoned

Date

APR 30 1941 19

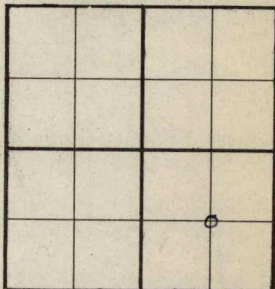
S. J. LEWIS Scout

Map No. 16 Sec. 5 Twp. 23 R. 11EWell No. 13 Seely "C"Sinclair Prairie Company

Contractor

COMPLETED

C SE

 Ft. from N. Line1320 Ft. from S. Line1320 Ft. from E. Line Ft. from W. Line**SECTION PLAT****MISCELLANEOUS**Location Rig up

Drilling and Remarks:

Bar 7/1947
5" C 1949
P.B. 2008
509 to 1974-2008.
Pump Soil
39 c/gv

RECORDCased in., ft.Sand Gas Oil Total Depth 2015**PRODUCTION**1st 24 hrs. Nat. 1st 24 hrs. after shot Gas Cu. Ft.Dry Hole Abandoned

Date

JUL 16 1941 19 S. J. LEWIS Scout