
Form 51 5M 7-22 9573

Map No. _____ Sec. 6 Twp. 23 R. 11

Well No. 1 Seely Farm

Sterling O. & R. Company

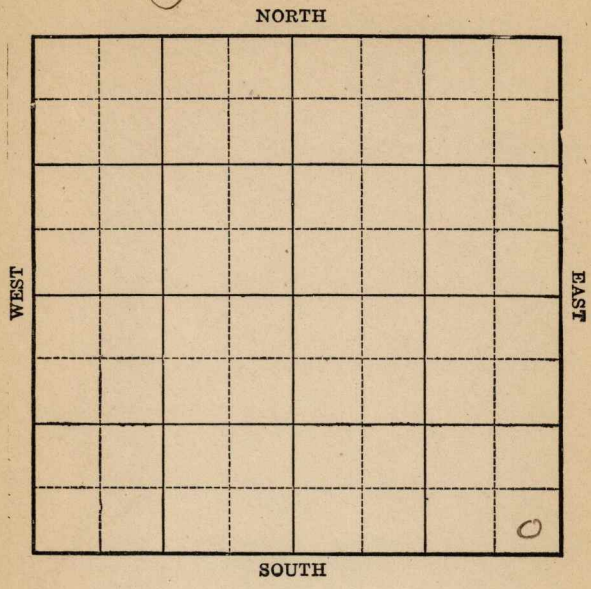

Location _____

Drilling Remarks:

Rig up _____

Drilling Remarks:

RECORD

Cased _____ in. _____ ft.

Sand _____

Gas _____

Oil _____

Total Depth _____

PRODUCTION

1st 24 hrs Nat. _____

1st 24 hrs. after shot _____

Gas _____ cu. ft.

Dry Hole _____

Abandoned _____

Form 252A 8M-11-20 PALACE-TULSA 4617

Map No. _____ Sec. 6 Twp. 23 R. 11

Well No. 1 Seely Farm


Sterling O. & R. Company

_____ Ft. from N. Line

330 Ft. from S. Line

330 Ft. from E. Line

_____ Ft. from W. Line

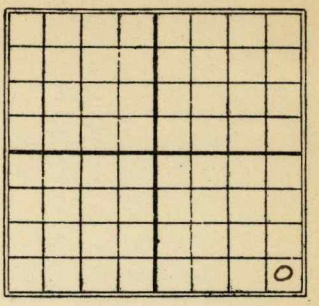

Date 1923	REPORT
3/2	Tubers.
5/19	Sand 1949-2043- Shot 150 qts. 100 Bbls.

Form 26—1M—4-19—Mid-West

Map No. KANSAS Sec. 6 Twp. 23 R. 11


Well No. 1 Seely

S. Sterling Oil & R. Company

Contractor

FIRST REPORT

SECTION PLAT

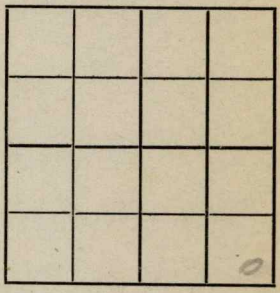

330 Ft. from N. Line

330 Ft. from S. Line

330 Ft. from E. Line

Ft. from W. Line

Location

Rig up

Drilling and Remarks:

Indians

RECORD

Cased in., ft.

Sand

Gas

Oil

Total Depth

PRODUCTION

1st 24 hrs. Nat.

1st 24 hrs. after shot

Gas Cu. Ft.

Dry Hole

Abandoned

Date

MAR 2 1923

191

M. A. BENEAR Scout

Form 26—1M—4-19—Mid-West

Map No. KANSAS Sec. 6 Twp. 23 R. 11


Well No. 1 Seely

Sterling B & R Company

Contractor

COMPLETED

SECTION PLAT

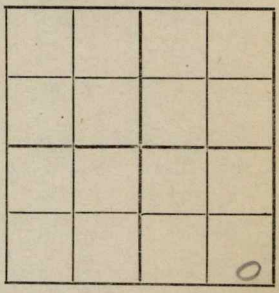

Ft. from N. Line

330 Ft. from S. Line

330 Ft. from E. Line

Ft. from W. Line

Location

Rig up

Drilling and Remarks:

sand 1949-2043

150/100 bbl

RECORD

Cased in., ft.

Sand

Gas

Oil

Total Depth

PRODUCTION

1st 24 hrs. Nat.

1st 24 hrs. after shot

Gas Cu. Ft.

Dry Hole

Abandoned

Date

MAY 19 1923

191

M. A. BENEAR

Scout