


Section 6 Township 23 Range 11E

Well No. #65 Seeley

Company Magnolia

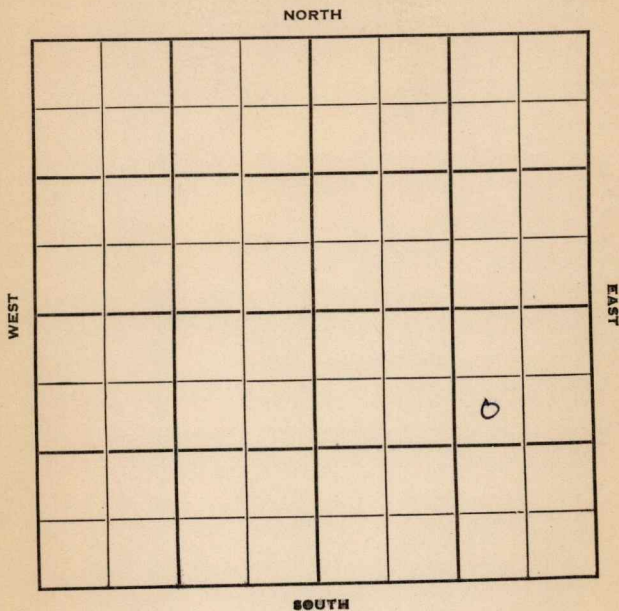

Greenwood

KANSAS ✓

Sec. 6 Twp. 23 R. 11E

Well No. #65 Seeley Farm

Magnolia Company

Contractor

Miscellaneous


990' Ft. from N. Line

Ft. from S. Line

990' Ft. from E. Line

Ft. from W. Line

SW NE SE

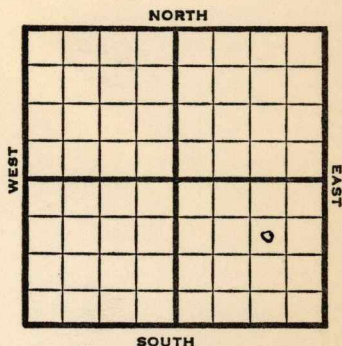

1950

REPORT

5/3

Rig up

5/31

8" @ 108

Bart 1952

5" @ 1990

TD 1991

20 qt 1955-62

comp 2 bopd

COMPLETED

Kansas

Miscellaneous

Map No. _____ Sec. 6 Twp. 23 R. 11EWell No. 65 Seeley_____Magnolia_____ Company_____ _____ Contractor

SW NE SE

990 Ft. from N. Line_____ Ft. from S. Line990 Ft. from E. Line_____ Ft. from W. LineGreenwood County

SECTION PLAT



Location _____

Rig up X

Drilling and Remarks:

RECORD

Cased _____ in., _____ ft.

Sand _____

Gas _____

Oil _____

Total Depth _____

PRODUCTION

1st 24 hrs. Nat. _____

1st 24 hrs. after shot _____

Gas _____ Cu. Ft.

Dry Hole _____

Abandoned _____

Date

MAY 3 1950 19J. E. TYRA Scout

Map No. _____ Sec. 6 Twp. 23 R. 11E

Well No. 65 Seeley

Magnolia Company

Contractor

SW NE SE

SECTION PLAT

990 Ft. from N. Line

_____ Ft. from S. Line

990 Ft. from E. Line

_____ Ft. from W. Line



Greenwood

Location _____

Rig up _____

Drilling and Remarks:

8" c 108
Bart. 1952
5" c 1990
T.D. 1991
20 qt. 1955-62
Cong. 2 bopd

RECORD

Cased _____ in., _____ ft.

Sand _____

Gas _____

Oil _____

Total Depth 1991

PRODUCTION

1st 24 hrs. Nat. _____

1st 24 hrs. after shot _____

Gas _____ Cu. Ft.

Dry Hole _____

Abandoned _____

Date

MAY 31 1950

19

J. E. TYRA Scout