


Sedgwick KANSAS

Section 8 Township 27 Range 2-E

Well No. 1 Jabes

Company Magnolia

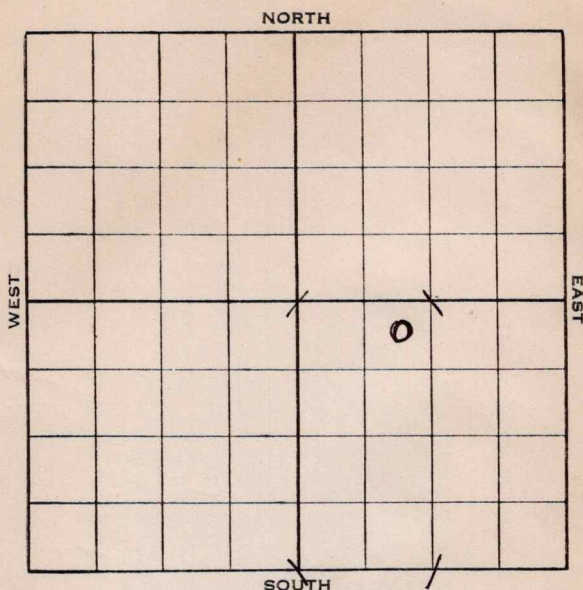

Map No. 12 Sec. 8 Twp. 27 R. 2EWell No. 1 JabesMagnolia

Company _____

Contractor _____

FIRST REPORT

NE NW SE


330 Ft. from N. Line

_____ Ft. from S. Line

_____ Ft. from E. Line

990 Ft. from W. Line

SECTION PLAT

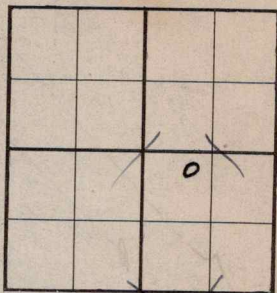

Location _____

Rig up _____

Drilling and Remarks:

RR

RECORD

Cased _____ in., _____ ft.

Sand _____

Gas _____

Oil _____

Total Depth _____

PRODUCTION

1st 24 hrs. Nat. _____

1st 24 hrs. after shot _____

Gas _____ Cu. Ft.

Dry Hole _____

Abandoned _____

Date

AUG 17 1938 19

H. D. Hatfield Scout

Sedgwick

KANSAS

Map No. 12 Sec. 8 Twp. 27 R. 2EWell No. 1 JabesMagnolia

Company

Contractor

ABANDONED

NE NW SE

330 Ft. from N. Line

Ft. from S. Line

Ft. from E. Line

990 Ft. from W. Line

SECTION PLAT

		0	

Location

RECORD

Cased _____ in., _____ ft.

Sand _____

Gas _____

Oil _____

Total Depth 3306

PRODUCTION

1st 24 hrs. Nat. _____

1st 24 hrs. after shot _____

Gas _____ Cu. Ft.

Dry Hole _____

Abandoned _____

Location

Rig up

Drilling and Remarks:

Misener 3279-81 1/2H.F.W.Viol 3300-06No showsD & A

Date

OCT 5 - 193819H. D. HatfieldScout