KANSAS


FORM 51 5M 4-41 PETROL

Sedgwick

Section 4 Township 27 Range 2-E

Well No. #1 Thompson

Company National Refining

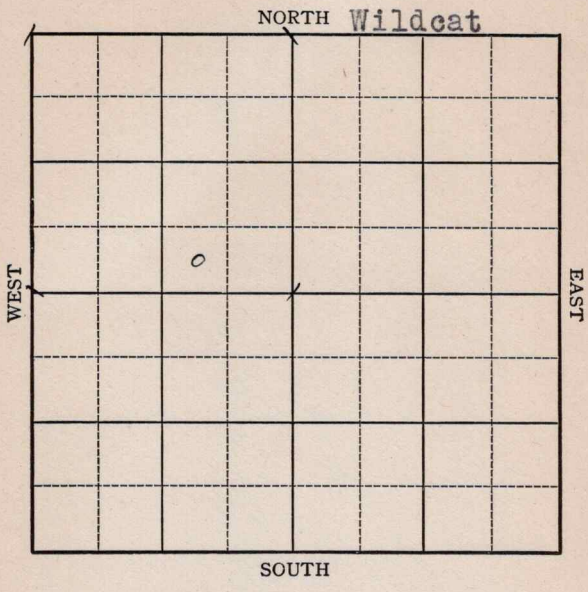

FORM 252-A 5M 6-41 PETROL KANSAS Sedgwick

Sec. 4 Twp. 27 R. 2-E

Well No. #1 Thompson Farm

National Refining Company


(Wildcat)

Ft. from N. Line

330 Ft. from S. Line

990 Ft. from E. Line

Ft. from W. Line

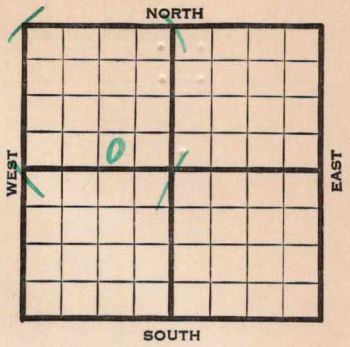

Elev. 1391

1941	REPORT
7/23	Cable
7/31	Spud
8/7	15" @ 100 Drlg. 1260'
8/15	12½" 1474 Dlg. 1935
8/21	" " "
8/28	Miss. 2965' T.D. 2967'
	To run casing.
9/4	6" - 2955' T.D. 2968'
	Pump 90 oil & 160 water per day
	for 3 days.
9/11	T.D. 3068' U.R. 6".
9/18	B. Miss. 3226' Viola 3276'
	H.F.W. 3287-91' T.D. P. B.
9/25	P.B. to 2980' 7" - 2962' WOC.
10/2	Pump 90 oil & 110 water in 24
	hours.

OVER

754833

1941
10/8 Miss. 2955'
6" - 2962'
T.D. 3291'
P.B. to 2980'
Potential 35 oil & 110 water.
43. Gravity

COMPLETED

Form 26 200 Bks. 5-41 McW. Sedgwick KANSAS

Map No. 12 Sec. 4 Twp. 27 R. 2E

Well No. 1 Thompson

National Refining Company

FIRST REPORT Contractor

SW SE NW

Ft. from N. Line


330 Ft. from S. Line

990 Ft. from E. Line

Ft. from W. Line

WILDCAT

SECTION PLAT

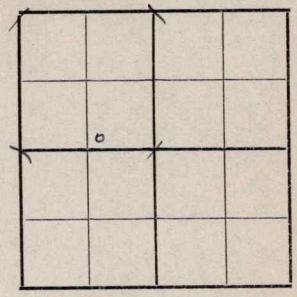

Location

Rig up

Drilling and Remarks:

Cable

RECORD

Cased in., ft.

Sand

Gas

Oil

Total Depth

PRODUCTION

1st 24 hrs. Nat.

1st 24 hrs. after shot

Gas Cu. Ft.

Dry Hole

Abandoned

Date

JUL 23 1941 19 S. J. LEWIS Scout

Form 26 200 Bks. 5-41 McW. Sedgwick KANSAS

Map No. K-12 Sec. 4 Twp. 27 R. 2E

Well No. 1 Thompson

National Refining Company

COMPLETED Contractor

SW SE NW

Ft. from N. Line


330 Ft. from S. Line

990 Ft. from E. Line

Ft. from W. Line

WILDCAT

SECTION PLAT

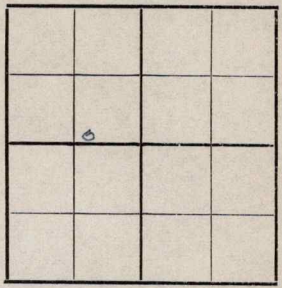

Location

Rig up

Drilling and Remarks:

Miss 2955
6" @ 2962
PB 2980.
Pump 35 oil 110 Wat
Pot.

43° Gr

RECORD

Cased in., ft.

Sand

Gas

Oil

Total Depth 3291

PRODUCTION

1st 24 hrs. Nat.

1st 24 hrs. after shot

Gas Cu. Ft.

Dry Hole

Abandoned

Date

OCT 8 1941 19

S. J. LEWIS Scout