


Map No. _____ Sec. 35 Twp. 26 R. 5Well No. S. Bisago Farm _____Morgan Lateral Company _____

N

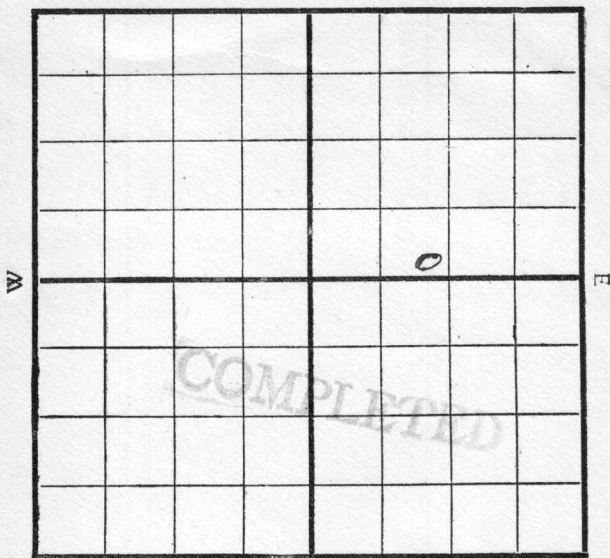

S

Location _____

Drilling Remarks:

RECORD

Cased _____ in. _____ ft.

Sand _____

Gas _____

Oil _____

Total Depth _____

Rig Up _____

Drilling Remarks:

PRODUCTION

1st 24 hrs. Nat. _____

1st 24 hrs. after shot _____

Gas _____ cu. ft.

Dry Hole _____

Abandoned _____

Map No. _____ Sec. 35 Twp. 26 R. 5

Well No. 5 Bisagno Farm

Morgan et al Company

Contractor


ME. Quarter

_____ Ft. from N. Line

700 Ft. from S. Line

_____ Ft. from E. Line

1120 Ft. from W. Line

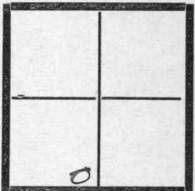

~~DATA~~

REPORT

Spudding.
175 2680 - 2704 - shot 30 gts
20 bbl.

Map No. K14 Sec. 35 Twp. 26 R. 5Well No. 5 BisagnaMorgan et al Company

Contractor

SECTION PLAT

Ft. from N. Line

200 Ft. from S. Line

Ft. from E. Line

1120 Ft. from W. Line

Location _____

Rig up _____

Drilling and Remarks:

Cased _____ in., _____ ft.

Sand _____

Gas _____

Oil _____

Total Depth _____

PRODUCTION

1st 24 hrs. Nat. _____

1st 24 hrs. after shot _____

Gas _____ Cu. Ft.

Dry Hole _____

Abandoned _____

Date

11/1 1919

Pyle

Scout

Map No. K14 Sec. 35 Twp. 26 R. 5Well No. 5 BisagnoMorgan et al Company

Contractor

SECTION PLAT

Ft. from N. Line

200 Ft. from S. Line

Ft. from E. Line

1120 Ft. from W. Line

Location

Rig up

Drilling and Remarks:

Shot 30 qts

RECORD

Cased _____ in., _____ ft.

Sand 2680-2704

Gas _____

Oil _____

Total Depth _____

PRODUCTION

1st 24 hrs. Nat. _____

1st 24 hrs. after shot 20 bbls

Gas _____ Cu. Ft.

Dry Hole _____

Abandoned _____

Date

Pyle

12/5 1919 Scout