


Map No. _____ Sec. 35 Twp. 26 R. 5Well No. 3 Bisagno Farm _____
Morgan et al Company _____

NORTH

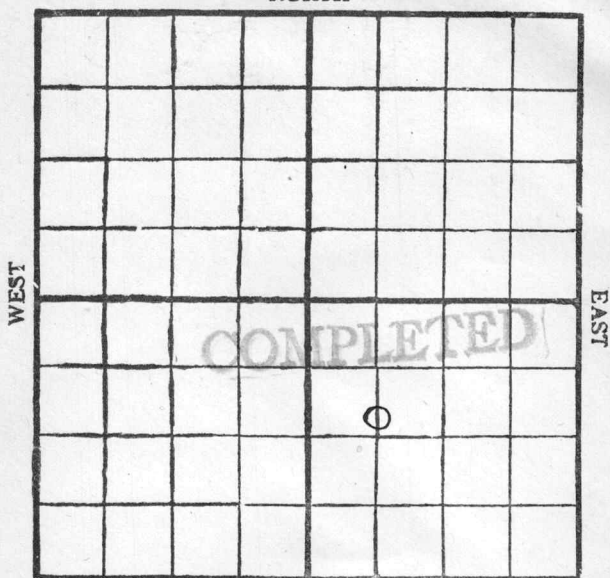

SOUTH

Location _____

Rig Up _____

Drilling Remarks:

Drilling Remarks:

RECORD

Cased _____ in. _____ ft.

Sand _____

Gas _____

Oil _____

Total Depth _____

PRODUCTION

1st 24 hrs. Nat. _____

1st 24 hrs. after shot _____

Gas _____ cu. ft.

Dry Hole _____

Abandoned _____

Map No. _____ Sec. 35 Twp. 26 R. 5

Well No. 3. Bisaguo Farm _____

Morgan et al Company _____


Contractor J. G. Quarter _____

11 20 Ft. from N. Lice

_____ Ft. from S. Line

11 20 Ft. from E. Line

_____ Ft. from W. Line

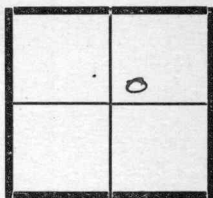

Date

REPORT

10/11

Rig.

10/27

2700-2722'- 50 Bbl.

COMPLETED

Map No. K 14 Sec. 35 Twp. 26 R. 5Well No. 3 BisagnoMorgan et al Company


Contractor

SECTION PLAT

1120 Ft. from N. Line

Ft. from S. Line

Ft. from E. Line

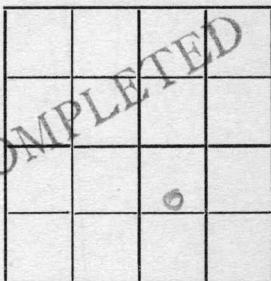660 Ft. from W. Line

Location

Rig up

Drilling and Remarks:

RECORD

Cased _____ in., _____ ft.

Sand 2700 - 2722

Gas _____

Oil _____

Total Depth _____

PRODUCTION

1st 24 hrs. Nat. 50 bbls

1st 24 hrs. after shot _____

Gas _____ Cu. Ft.

Dry Hole _____

Abandoned _____

Date

10/27 1919

Scout

Pyle

Map No. K14 Sec. 35 Twp. 26 R. 5
 Well No. 3 Bisagno
Morgan et al Company
 Contractor

NORTH

WEST

EAST

FIRST REPORT

SOUTH

Location _____

Rig up _____

Drilling and Remarks:

RECORD

Cased _____ in., _____ ft.

Sand _____

Gas _____

Oil _____

Total Depth _____

PRODUCTION

1st 24 hrs. Nat. _____

1st 24 hrs. after shot _____

Gas _____ Cu. Ft.

Dry Hole _____

Abandoned _____

Date

April 8 1919 Pyle Scout