


Map No. _____ Sec. 32 Twp. 26 R. 5
 Well No. 6 Mill Farm _____
Theta Oil Company _____

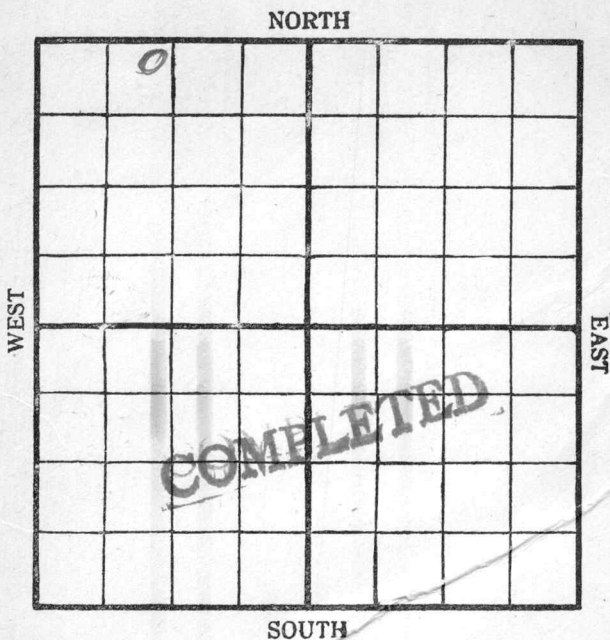

Location _____

Drilling Remarks:

Rig Up _____

Drilling Remarks:

RECORD

Cased _____ in. _____ ft.

Sand _____

Gas _____

Oil _____

Total Depth _____

PRODUCTION

1st 24 hrs. Nat. _____

1st 24 hrs. after shot _____

Gas _____ cu. ft

Dry Hole _____


Abandoned _____

1004 K14 Map No. 32 Sec. 26 Twp. 5 R.

Well No. 6 Hill Farm
Theta Oil Company

NORTH

WEST

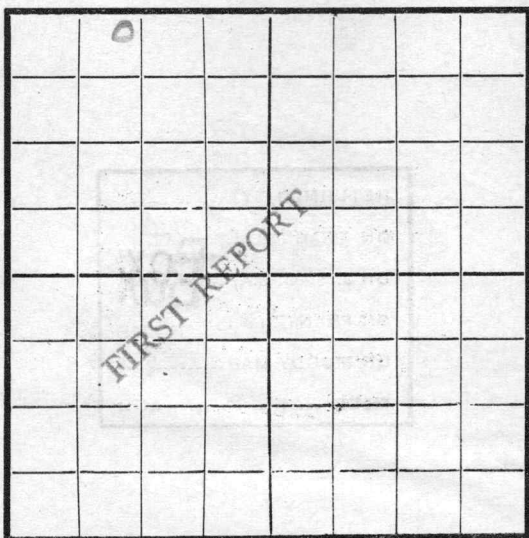

EAST

SOUTH

Location ✓Rig Up ✓

Drilling and remarks

RECORD

Cased _____ in. _____ Ft.

Sand _____

Gas _____

Oil _____

Total Depth _____

PRODUCTION

1st 24 hrs. Nat. _____

1st 24 hrs. after shot _____

Gas _____ Cu. Ft.

Dry Hole _____

Abandoned _____


Date

6/19, 1918 Oyle Scout

Map No. _____ Sec. 32 Twp. 26 R. 5Well No. 6 Still Farm _____
Theta Oil Company

NORTH

WEST

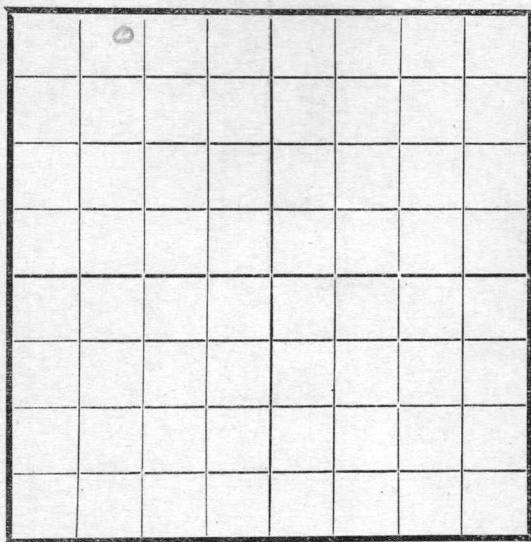

EAST

SOUTH

Location _____

Rig Up ☒ _____

Drilling and remarks _____

RECORD

Cased _____ in _____ Ft.

Sand _____

Gas _____

Oil _____

Total Depth _____

PRODUCTION

1st 24 hrs. Nat. _____

1st 24 hrs. after shot _____

Gas _____ Cu. Ft.

Dry Hole _____

Abandoned _____

Date


4/24, 1918 Cyle Scout

Map No. _____ Sec. 32 Twp. 26 R. 5

Well No. 6 Kill Farm _____
Theta Oil Company

NORTH

WEST

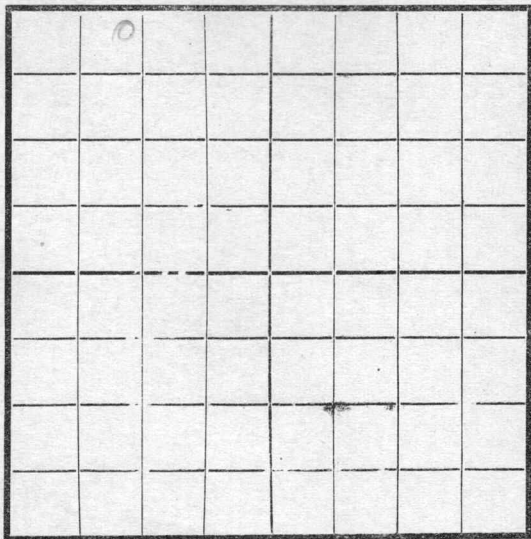

EAST

SOUTH

Location _____

Rig Up _____

Drilling and remarks

Tools in

RECORD

Cased _____ in. _____ Ft.

Sand _____

Gas _____

Oil _____

Total Depth _____

PRODUCTION

1st 24 hrs. Nat. _____

1st 24 hrs. after shot _____

Gas _____ Cu. Ft.

Dry Hole _____

Abandoned _____


Date

5/1, 1918 Oye Scout


NORTH

WEST

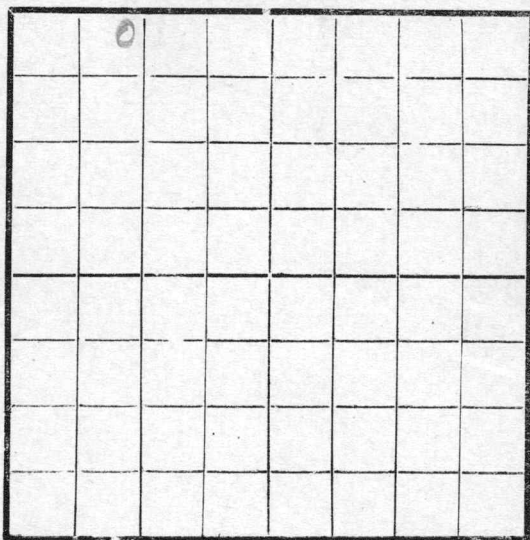

EAST

SOUTH

Location _____

Rig Up _____

Drilling and remarks

tools in

RECORD

Cased _____ in. _____ Ft.

Sand _____

Gas _____

Oil _____

Total Depth _____

PRODUCTION

1st 24 hrs. Nat. _____

1st 24 hrs. after shot _____

Gas _____ Cu. Ft.

Dry Hole _____

Abandoned _____


Date

5/8, 1918 Dyle Scout

Map No. _____ Sec. 32 Twp. 26 R. 5Well No. 6 Kill Farm _____Thela Oil Company _____

NORTH

WEST

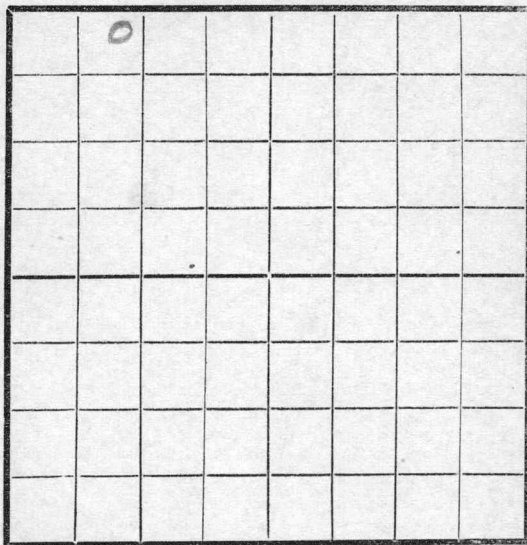

EAST

SOUTH

Location _____

Rig Up _____

Drilling and remarks

RECORD

Cased _____ in. _____ Ft.

Sand _____

Gas _____

Oil _____

Total Depth _____

PRODUCTION

1st 24 hrs. Nat. _____

1st 24 hrs. after shot _____

Gas _____ Cu. Ft.

Dry Hole _____

Abandoned _____


Date

5/15 1918 Cyle Scout

Map No. _____ Sec. 32 Twp. 26 R. 5Well No. 45 Hill Farm _____Thit & Co. Company _____

NORTH

WEST

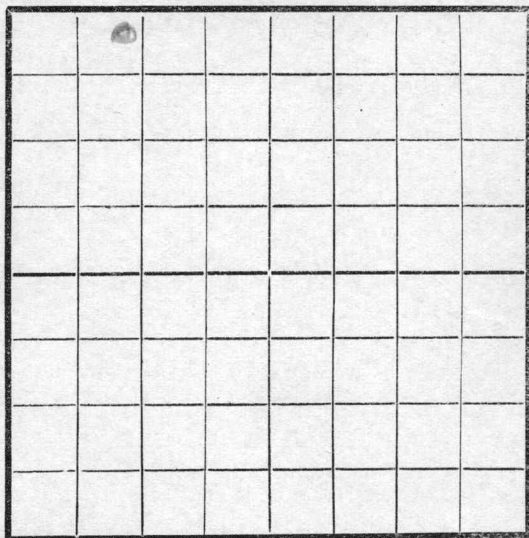

EAST

SOUTH

Location _____

Rig Up _____

Drilling and remarks

750'

RECORD

Cased _____ in. _____ Ft.

Sand _____

Gas _____

Oil _____

Total Depth _____

PRODUCTION

1st 24 hrs. Nat. _____

1st 24 hrs. after shot _____

Gas _____ Cu. Ft.


Dry Hole _____

Abandoned _____

Date

5/8, 1918 Open Scout92

Map No. _____ Sec. 32 Twp. 24 R. 5
 Well No. 4 Still
Theta Well Company _____
 Contractor _____

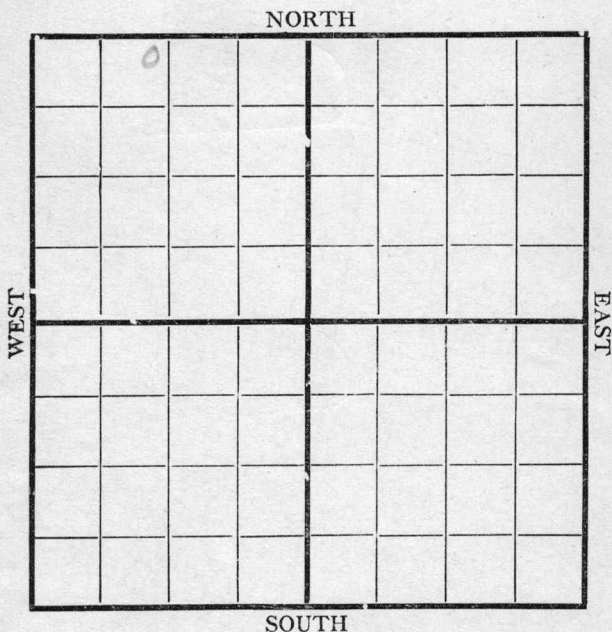

	RECORD
Location _____	Cased _____ in., _____ ft.
Rig up _____	Sand _____
Drilling and Remarks:	Gas _____
1300'	Oil _____
	Total Depth _____
	PRODUCTION
	1st 24 hrs. Nat. _____
	1st 24 hrs. after shot _____
	Gas _____ Cu. Ft.
	Dry Hole _____
	Abandoned _____

Date 5/28 1918 Cyle Scout


Contractor _____

NORTH

WEST

EAST

SOUTH

Location _____

Rig up _____

Drilling and Remarks:

1520

RECORD

Cased _____ in., _____ ft.

Sand _____

Gas _____

Oil _____

Total Depth _____

PRODUCTION

1st 24 hrs. Nat. _____

1st 24 hrs. after shot _____

Gas _____ Cu. Ft.

Dry Hole _____

Abandoned _____

Date


6/5 1918 Dyke Scout

Map No. _____ Sec. 32 Twp. 24 R. 5

Well No. 6 Hill
Theta oil Company _____

Contractor _____

NORTH

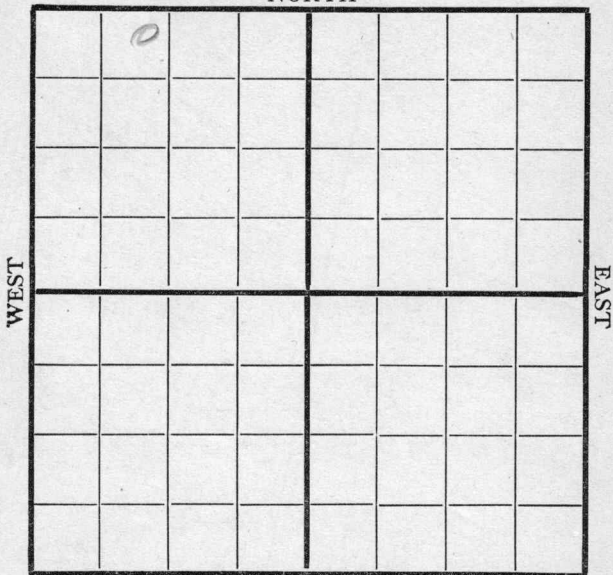

SOUTH

Location _____

Rig up _____

Drilling and Remarks:

fishing
@
1750'

RECORD

Cased _____ in., _____ ft.

Sand _____

Gas _____

Oil _____

Total Depth _____

PRODUCTION

1st 24 hrs. Nat. _____

1st 24 hrs. after shot _____

Gas _____ Cu. Ft.

Dry Hole _____

Abandoned _____

Date

6/11 1918 Oyle Scout

Map No. _____ Sec. 32 Twp. 26 R. 5
 Well No. 6 Still
 Contractor _____

NORTH							
WEST							
SOUTH							

	RECORD	
Location _____	Cased _____ in., _____ ft.	
Rig up _____	Sand _____	
Drilling and Remarks:	Gas _____	
<u>fishing</u> <u>tools @</u> <u>1750'</u>	Oil _____	
	Total Depth _____	
	PRODUCTION	
	1st 24 hrs. Nat. _____	
	1st 24 hrs. after shot _____	
	Gas _____ Cu. Ft.	
	Dry Hole _____	
	Abandoned _____	

Date 4/19 1918 Oyle Scout

WEST

EAST

SOUTH

Location _____

Rig up.....

Drilling and Remarks:

RECORD

Cased _____ in., _____ ft.

Sand_____

Gas -----

Oil _____

Total Depth.....

PRODUCTION

1st 24 hrs. Nat. -----

1st 24 hrs. after shot-----

Gas.....Cu. Ft.

Dry Hole


Abandoned.....

Date _____

191

Scott

Map No. _____ Sec. 32 Twp. 26 R. 5
Well No. 62 Hill
Theto Oil Company
Contractor _____

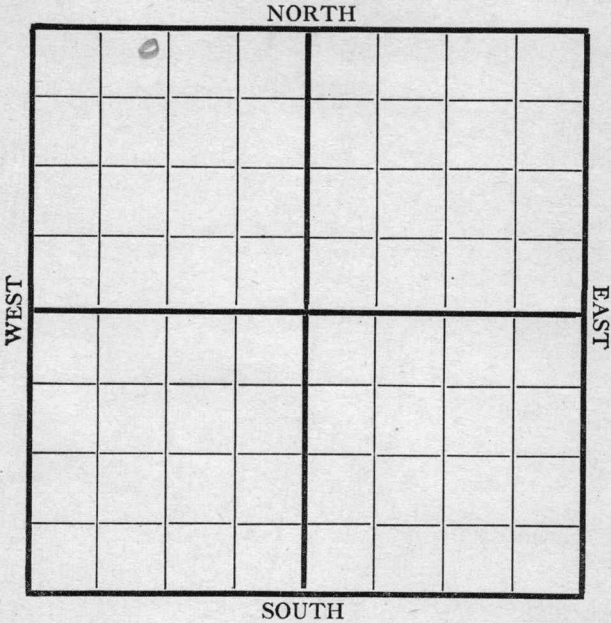

Location _____
Rig up _____
Drilling and Remarks:

2360

RECORD

Cased _____ in., _____ ft.
Sand _____
Gas _____
Oil _____
Total Depth _____

PRODUCTION


1st 24 hrs. Nat. _____
1st 24 hrs. after shot _____
Gas _____ Cu. Ft.
Dry Hole _____
Abandoned _____

Date 7/3 1918 Cyle Scout

Map No. _____ Sec. 37 Twp. 26 R. 5Well No. 6 Hill Farm _____
Theta Oil Company _____

NORTH

WEST

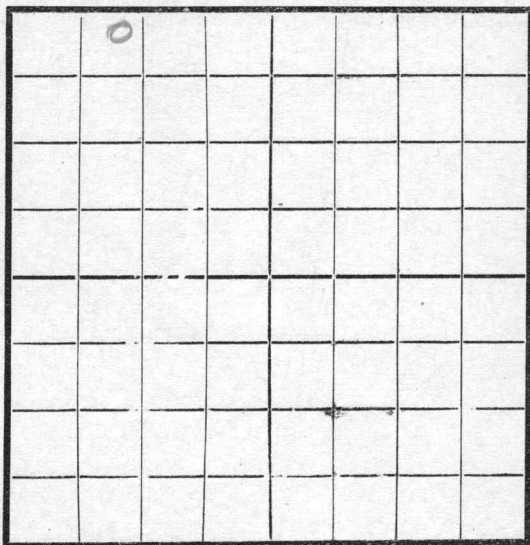

EAST

SOUTH

Location _____

Rig Up _____

Drilling and remarks

2480'

RECORD

Cased _____ in. _____ Ft.

Sand _____

Gas _____

Oil _____

Total Depth _____

PRODUCTION

1st 24 hrs. Nat. _____

1st 24 hrs. after shot _____

Gas _____ Cu. Ft.

Dry Hole _____

Abandoned _____

Date

7/10, 1918 Oyle Scout

Map No. _____ Sec. 32 Twp. 26 R. 5Well No. 6 Thita Oil _____ Company _____

Contractor _____

NORTH

WEST

EAST

SOUTH

Location _____

Rig up _____

Drilling and Remarks:

2600'

RECORD

Cased _____ in., _____ ft.

Sand _____

Gas _____

Oil _____

Total Depth _____

PRODUCTION

1st 24 hrs. Nat. _____

1st 24 hrs. after shot _____

Gas _____ Cu. Ft.

Dry Hole _____

Abandoned _____

Date

7/16 1918Cyph Scout

Map No. _____ Sec. 32 Twp. 26 R. 5

Well No. 6 Hill
Theta Oil Company

Company

Contractor

NORTH

WEST

EAST

SOUTH

Location -----

Rig up_____

Drilling and Remarks:

RECORD

Cased_____in., _____ft.

Sand_____

Gas _____

Oil.....

Total Depth.....

PRODUCTION

1st 24 hrs. Nat. -----

1st 24 hrs. after shot-----

Gas.....Cu. Ft.

Dry Hole.....

Abandoned.....

Date _____

191

Scout

Map No. 1004 N14 Sec. 32 Twp. 26 R. 5Well No. 61 HillTheta Oil Company

Contractor

NORTH

		0					

WEST

EAST

SOUTH

Location _____

Rig up _____

Drilling and Remarks:

RECORD

Cased _____ in., _____ ft.

Sand 2627-2643

Gas _____

Oil _____

Total Depth _____

PRODUCTION

1st 24 hrs. Nat. 10 bbls

1st 24 hrs. after shot _____

Gas _____ Cu. Ft.

Dry Hole _____

Abandoned _____

Date

8/1

8

C. y. w.

Scout