


SECTION 8 TOWNSHIP 23 RANGE 11 E

WELL NO. #33 McGilvray "A"

COMPANY Phillips Pet.

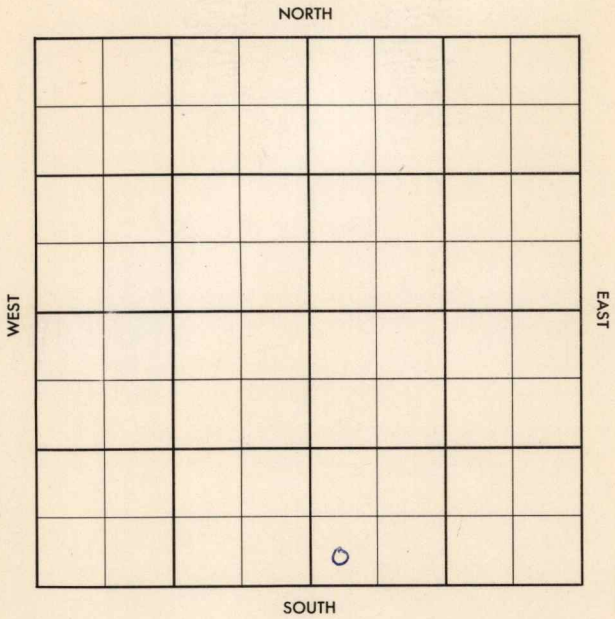

SEC.	TWP.	R.
8	23	11E


WELL NO.	
#33 McGilvray "A"	FARM
COMPANY	

CONTRACTOR
Phillips Petr.

Jackman

Sealy-Wick
Ft. from N. Line
330 Ft. from S. Line
Ft. from E. Line
330 Ft. from W. Line

of SE 1/4
SW SW SE

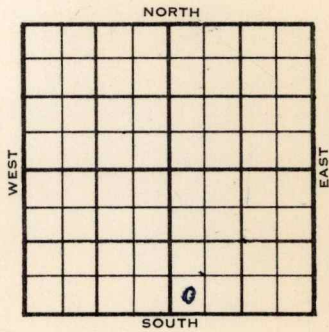

1956	ELEVATION 1212'	REPORT
------	--------------------	--------

1-11	XXXXXXXXXXXX Comm. 1-7-56 8" @ 92/65 Drlg. 641	(FR Tkt)
------	--	----------

2/3	Spud 1-7-56 Flowed 30 BO 24 hrs. Perfs 1937-50'- 1952-54'-1956-58'- 1966-68'- & 1970-76' TD 2016' Bartlesville Zone. -COMPLETE (DR#24)	
-----	--	--

County Greenwood Elev. 1212
 Sec. 8 Twp. 23 Rge. 11E
 Company Phillips Petroleum
 Farm Name McGilvray "A" No. 33

TOPS	DEPTH	LOG	DATUM	Loc. in Sec.
Arch				SW SW SE
Top				
H.				
Tr.	<u>132ft</u>	<u>1910</u>	<u>697</u>	
Bo.				
Bl.				
L.				
Kc.				Cool.
Shc.				
Co.				Conts
C.				<u>Jackman</u>
Sh.				
Sh.				
Sh.				Pool
Sh.				<u>Sealy-Wick</u>
U.				COMPLETE
S.				
S.				
A.				
R.				
Pe.				
O.				
To.	<u>2016</u>			

Date Comm. 1-7-56 FEB 29 1956

8" @ 92/65 drg. 641 JAN 18 '56 5 1/2 @
19801 JAN 25 '56 ca 78/1937-50
12/1952-54 12/1956-58 12/
1966-68 36/1970-76 Frac
8 Ld. FEB 1 '56 FEB 8 '56 Flw 30 Bopd
FEB 18 '56 Pop P. 5 B0 + 5 Bwpd
FEB 22 '56 P 2 B0 + 8 BW 24 hrs
FEB 29 '56 P 2 B0 + 10 Bwpd

Date Comm. 1-7-56
8" @ 92/65 drlg. 641