


DX 78-1 Sedgwick

KANSAS

Section 33 Township 29 Range 2W

Well No. #1 Lauterbach

Company Beardmore Drlg

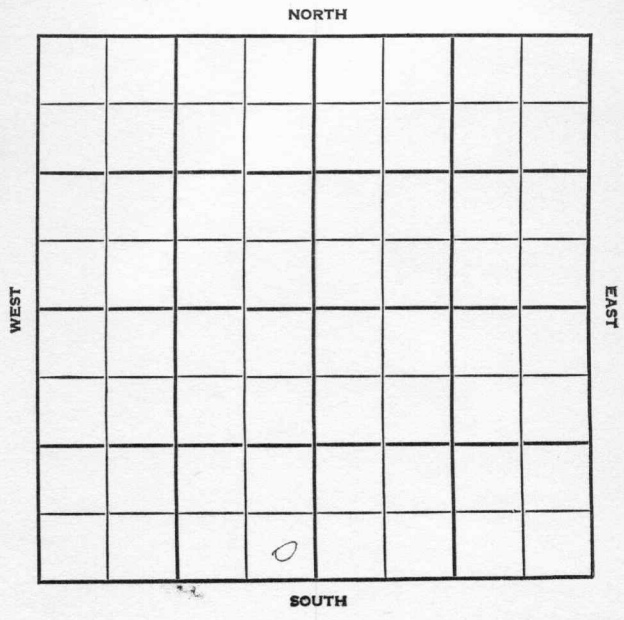

Sedgwick

KANSAS

SEC.	TWP.	R.
33	29	2W

WELL NO.

#1 Lauterbach

FARM

COMPANY

Beardmore Drlg.

CONTRACTOR

Renfro

WILDCAT


____ FT. FROM N. LINE

____ FT. FROM S. LINE

____ FT. FROM E. LINE

____ FT. FROM W. LINE

SE SE SW

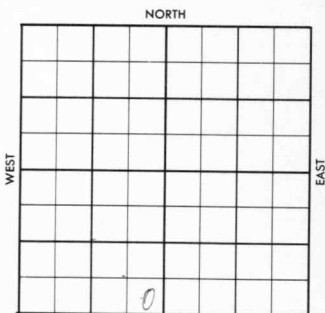

CSO-AC

ELEVATION

REPORT

1956

7-25

Comm. 7-22-56
8 5/8" @ 116 w/125
Drlg. 975

County Sedgwick Elev. _____
 Sec. 33 Twp. 29 Rge. 2W
 Company Beardmore Drlg.
 Farm Name Lauterbach No. 1

TOPS	DEPTH	LOG	DATUM	Loc. in Sec.
Anh.				SE SE SW
Tp.				
H.				
Tr.				
Dg.				
Bl.				
L.				
K.C.				Geol. _____
B.K.C.				Contr. _____
Ce.				<u>Renfro</u>
C.				
M.				Pool _____
K.				<u>Wildcat</u>
Mz.				
Ma.				
V.				
S.				
S.				
A.				
R.				
Pe.				
G.				
T.D.				

FIRST REPORT

JUL 25 1956

Date Comm. 7-22-56 CSO- AC
8 5/8" @ 116/125 d rlg. 975

2201 I 30A

R.G.

County Sevier Elev. 1290
 Sec. 33 Twp. 29 Rge. 2W
 Company Peasmore Drlg.
 Farm Name Leuterbach No. 1

TOPS	DEPTH	LOG	DATUM	Loc. in Sec.
Anh.				SW
Tr.				450 EL
Dg.				
BL.				
L.	2983			
K.C.				Geol.
B.K.C.	3197			Confr.
Ce.				Renfro
C.				Latta N
M.	3632			Pool
M.				Widert
K.				
Mz.				
Ma.				
V.				
S.				
S.				
A.				
R.				
PE.				
G.				
T.D.	3684			

COMPLETE
 SEP 19 '56

Date Comm. 7-22-56 750-40
8 5/8" @ 116/125 drlg. 75 AUG 1 '56

DST 2985-3005 30" Tool
 plgd. DST 3006-40 20" ree
 175' GCM & SW BHP -
 DST 3110-30 75" ree 156'
 50' GCM + 350' M & GCO + 10'
 Md BHP DST 3153-20
 75" ree 145' MW BHP 1080/20"
 AUG 8 '56 5 1/2 3189/75 CO

AUG 15 '56

30/3117-22 t5t 1

BFph 440 Wtr N2 \$ 22

B0 + Tr. Wtr t5t 8 BFph

1/3 Wtr POP AUG 22 '56 AUG 29 '56 P

4 Boph + 2 Bwph SEP 5 '56

SEP 12 '56

SEP 19 '56

Ph P. 120

Bopd + 30% gran 37.5°

33-29-2W