

Map No. Kansas Sec. 8 Twp. 23 R. 11

Well No. 2 Oliver Farm

Pure Oil Company

NORTH

WEST

EAST

SOUTH

Location _____

Drilling Remarks

Rig Up _____

Drilling Remarks

RECORD

Cased _____ in. _____ ft.

Sand _____

Gas _____

Oil _____

Total Depth _____

PRODUCTION

1st 24 hrs. Nat. _____

1st 24 hrs. after shot _____

Gas _____ cu. ft.

Dry Hole _____

Abandoned _____

KANSAS

Map No. _____ Sec. 8 Twp. 23 R. 11

Well No. 2 Oliver Farm

Pure Oil Company


NORTH

330 Ft. from N. Line

Ft. from S. Line

990' Ft. from E. Line

Ft. from W. Line

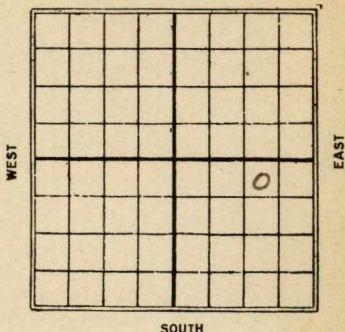

SOUTH

1925

Date _____

REPORT

19/8 Tomura

10/16	Right up
-------	----------

10/32 Spudding

10/29 L'Orly Zoo

11/19 Sand 1927-1975

120 gts 35 Bbls

Greenwood Co
 Map No. *K16* **KANSAS** Sec. *18* Twp. *23* R. *11*
 Well No. *2* *Oliver*
Hub Oil Co Company

Contractor

FIRST REPORTS

SECTION PLAT

330

Ft. from N. Line

Ft. from S. Line

990

Ft. from E. Line

Ft. from W. Line

			o

Location *Timbers*

Rig up

Drilling and Remarks:

RECORD

Cased _____ in., _____ ft.

Sand _____

Gas _____

Oil _____

Total Depth _____

PRODUCTION

1st 24 hrs. Nat. _____

1st 24 hrs. after shot _____

Gas _____ Cu. Ft.

Dry Hole _____

Abandoned _____

Date

OCT 8 1925

192

CHAS. L. SHERWOOD

Scout

Map No. *K16* **KANSAS** Sec. *8* Twp. *23* R. *11*

Well No. *2 Oliver*
Pure Oil Co Company

COMPLETED

Contractor

SECTION PLAT

330 Ft. from N. Line

_____ Ft. from S. Line

990 Ft. from E. Line

_____ Ft. from W. Line

Location _____

Rig up _____

Drilling and Remarks:

6" 1927
ad 1973-75'

1207 35 bhs.

RECORD

Cased _____ in., _____ ft.

Sand *1927-1975*

Gas _____

Oil _____

Total Depth *1975'***PRODUCTION**

1st 24 hrs. Nat. _____

1st 24 hrs. after shot _____

Gas _____ Cu. Ft.

Dry Hole _____

Abandoned _____

Date

NOV 19 1925 **CHAS. L. SHERWOOD**

192_____

Scout