
Form 51 5M 2-22 ~~8411~~

Map No. 7 Sec. 8 Twp. 23 R. 11

Well No. 1 Ohmer (Oliver) Farm

Pulaski Company

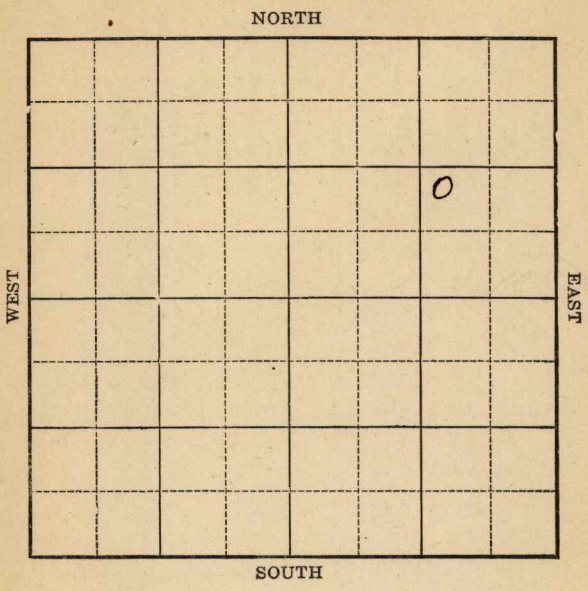

Location _____

Drilling Remarks:

Rig Up _____

Drilling Remarks:

RECORD

Cased _____ in. _____ ft.

Sand _____

Gas _____

Oil _____

Total Depth _____

PRODUCTION

1st 24 hrs. Nat. _____

1st 24 hrs. after shot _____

Gas _____ cu. ft.

Dry Hole _____

Abandoned _____

Form 252A 5M 4-22 8765

Map No. K Sec. 8 Twp. 23 R. 11

Well No. 1 Abner Farm


Pubaki Company

940 Ft. from N. Line

990 Ft. from S. Line

Ft. from E. Line

Ft. from W. Line

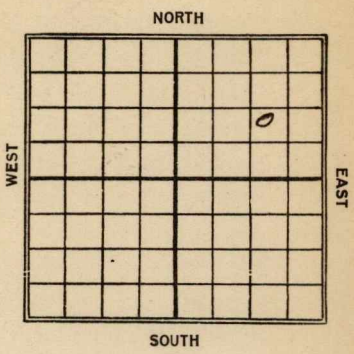

Date 1973	REPORT
8/29	1895-1970 Sand
11/74	1895-1946-
	Plug back-1940
	Shot 140/280 Shots

Form 26—1M Bks.—3-23—11959.

Map No. KANSAS Sec. 16 8 Twp. 23 11 R. ____


Well No. 1 Oliver

Siulaski Company

Contractor

FIRST REPORT

SECTION PLAT

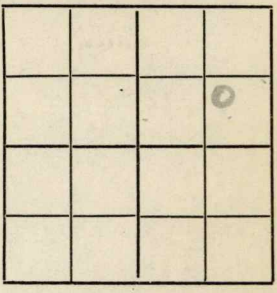

____Ft. from N. Line

990 Ft. from S. Line

990 Ft. from E. Line

____Ft. from W. Line

Location ____

Rig up ____

Drilling and Remarks:

Top S. 1895
To 1920

RECORD

Cased____in., ____ ft.

Sand ____

Gas ____

Oil ____

Total Depth ____

PRODUCTION

1st 24 hrs. Nat. ____

1st 24 hrs. after shot ____

Gas ____ Cu. Ft.

Dry Hole ____

Abandoned ____

Date

SEP 29 1923

____192____.

M. A. BENEAR

____Scout

Form 26—1M Bks.—3-23—11959.

Map No. KANSAS 16 Sec. 7 Twp. 23 R. 11


Well No. 1 Dwyer

Zulauski Company

Contractor

COMPLETED

SECTION PLAT

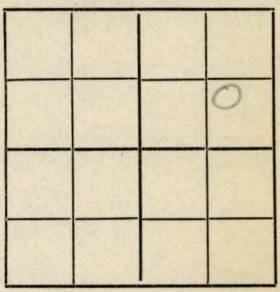

990 Ft. from N. Line

990 Ft. from S. Line

Ft. from E. Line

Ft. from W. Line

Location

Rig up

Drilling and Remarks:

sand 1895
1946
Rlug back 1940
140/250 bbls

RECORD

Cased in., ft.

Sand

Gas

Oil

Total Depth

PRODUCTION

1st 24 hrs. Nat.

1st 24 hrs. after shot

Gas Cu. Ft.

Dry Hole

Abandoned

Date

NOV 24 1923 192

M. A. BENEAR Scout