

Section 2 Township 20 Range 2-EWell No. 1 SchmidtCompany W. R. Yeager et al

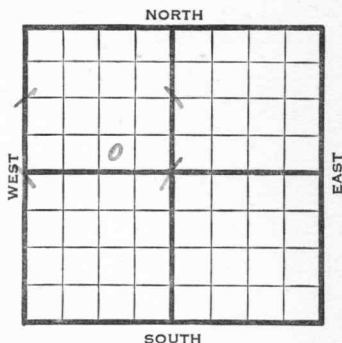
		NORTH				Wildcat	
WEST							
			0				
		SOUTH					

285

clw 1400

KANSAS

Marion

Sec. 2 Twp. 20 R. 2-EWell No. #1 Schmidt FarmW. R. Yeager et al Company
(Wildcat) Ft. from N. Line330 Ft. from S. Line990 Ft. from E. Line Ft. from W. Line

		REPORT
1942	1400 - L&S	
2/11	15" - 101'	
	Drlg. 230'	
2/19	12" - 802' Drlg. 965'	
2/26	10" - 1400' Drlg. 1555'	
3/5	Drlg. 1970'	
3/12	Lans. 1958' 2010' run 8".	
3/19	" " " "	1958
3/26	Shut down.	1400 555
4/2	" " Lan-558	
4/8	" " BKC-898	
4/15	" " M-1194	
4/22	8" - 2010' Drlg. 2100' L-M 636	
4/29	Drlg. 2300' BKC-M 296	
5/6	2300' U.R. 8".	
5/13	Lans. 1959' 8" - 2275' BKC 2298'	
	Miss. 2594-96' T.D. Run 7".	1400 848
5/20	7" - 2618' Drlg. 2685'	
5/27	B. Miss. 2690' Viola 2978'	2594 1400
	Drlg. 2986'	1194 558
		1194 898 636
	OVER	296

1942

6/3

Viola 2978'

7" - 2690'

T.D. 2997'

H.F.W.

ABANDONED

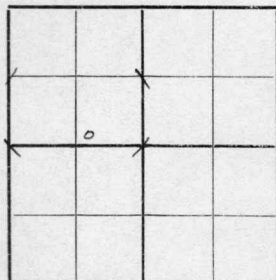
Marion

KANSAS

Map No. 24 Sec. 2 Twp. 20 R. 2EWell No. 1 SchmidtW. R. Yeager et al. CompanyFIRST REPORT Contractor

S W SE NW

SECTION PLAT

 Ft. from N. Line330 Ft. from S. Line990 Ft. from E. Line Ft. from W. Line

WILDCAT

Location Rig up

Drilling and Remarks:

15" - 101'Dr1g. 230'

RECORD

Cased in., ft.Sand Gas Oil Total Depth

PRODUCTION

1st 24 hrs. Nat. 1st 24 hrs. after shot Gas Cu. Ft.Dry Hole Abandoned

Date

FEB. 1 1 1942 19

S. J. LEWIS

Scout

Map No. 24 Sec. 2 Twp. 20 R. 2EWell No. 1 SchmidtW. R. Yeager et al. Company**ABANDONED**

Contractor

SW SE NW

SECTION PLAT

	0		

 Ft. from N. Line330 Ft. from S. Line990 Ft. from E. Line Ft. from W. Line

WILDCAT

Location Rig up

Drilling and Remarks:

Vista 2975.2" C2690XFW

RECORD

Cased in., ft.Sand Gas Oil Total Depth 2997

PRODUCTION

1st 24 hrs. Nat. 1st 24 hrs. after shot Gas Cu. Ft.Dry Hole Abandoned

Date

JUN 3 1942 19S. J. LEWIS Scout