


Marion

Section 4 Township 20 Range 1-E

Well No. #1 Peters Est

Company Mallard Drlg

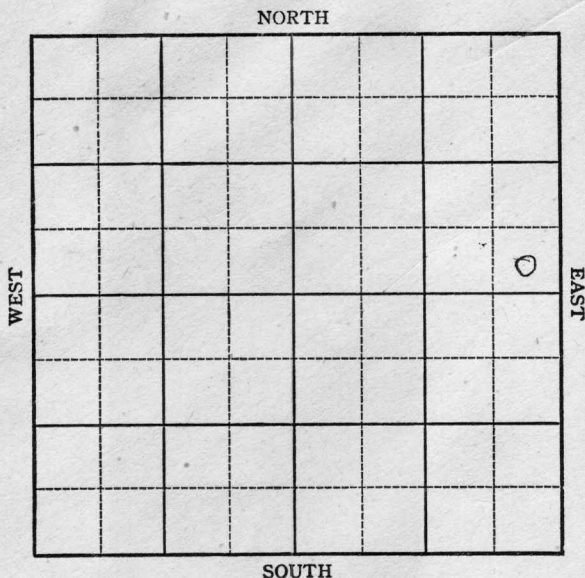

KANSAS

Wildcat

Sec. 4 Twp. 20 R. 1-E

Well No. 1 Peters Est. Farm

Mallard Drlg. Company


SE NE

 Ft. from N. Line

330 Ft. from S. Line

330 Ft. from E. Line

 Ft. from W. Line

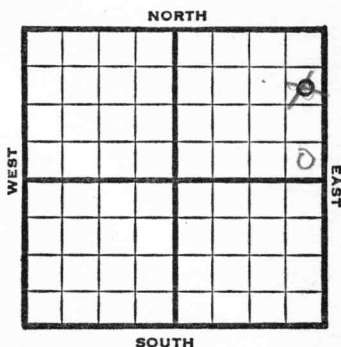

Marion County

1947 Elev. 1447 REPORT

2-12 RUR

2/19 8" @ 162'
Drlg 2255'

2/26 Lans 2174'
Viola 3187
Simp 3244
TD 3273'

ABANDONED

Map No. 24 Sec. 4 Twp. 20 R. 1EWell No. 1 Peters Est.Mallard Drlg. Company

FIRST REPORT

Contractor

SE NE

SECTION PLAT

			o

Ft. from N. Line330 Ft. from S. Line330 Ft. from E. LineFt. from W. Line

Marion County

Location

Rig up

Drilling and Remarks:

R U R

RECORD

Cased _____ in., _____ ft.

Sand _____

Gas _____

Oil _____

Total Depth, _____

PRODUCTION

1st 24 hrs. Nat. _____

1st 24 hrs. after shot _____

Gas _____ Cu. Ft.

Dry Hole _____

Abandoned _____

Date

FEB 12 1947 19S. J. LEWIS Scout

Map No. 24 Sec. 4 Twp. 20 R. 1E

Well No. 1 Peters Est.

Mallard Drlg. Company

ABANDONED

Contractor

SE NE


E11447
SECTION PLAT

 Ft. from N. Line

330 Ft. from S. Line

330 Ft. from E. Line

 Ft. from W. Line

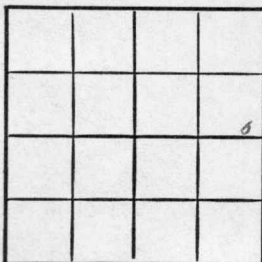

Marion County

Location

Rig up

Drilling and Remarks:

Lease 2174

W. 1/4 3187

Comp 3244

RECORD

Cased in., ft.

Sand

Gas

Oil

Total Depth 3228

PRODUCTION

1st 24 hrs. Nat.

1st 24 hrs. after shot

Gas Cu. Ft.

Dry Hole

Abandoned

Date

FEB 26 1947 19

S. J. LEWIS Scout