


Map No. Kan Sec. 9 Twp. 23 R. 11
Well No. 2 Diffany Farm
G. K. Simmons Company

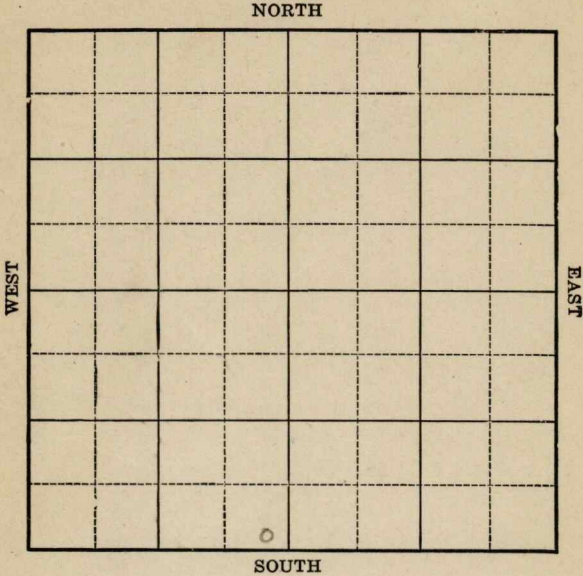

Location _____
Drilling Remarks _____

Rig Up _____
Drilling Remarks _____

RECORD

Cased _____ in. _____ ft.
Sand _____
Gas _____
Oil _____
Total Depth _____

PRODUCTION

1st 24 hrs. Nat. _____
1st. 24 hrs. after shot _____
Gas _____ cu. ft.
Dry Hole _____
Abandoned _____

Map No. *Kan* Sec. *9* Twp. *23* R. *11*Well No. *2 Tiffany* Farm
J. K. Simmons Company

Ft. from N. Line

300 Ft. from S. Line*300* Ft. from E. Line

Ft. from W. Line

NORTH

WEST

EAST

SOUTH

C

Date

REPORT

*1925**7/10 Timbers**7/17* _____*7/24* _____*7/31* _____*8/7* _____*8/14* _____*8/20* _____*8/26* _____*9/3 Location only**9/11* _____*9/16* _____*9/24* _____*10/1* _____*10/8* _____*10/16* _____*10/22* _____*10/29 Only @ 330'**11/19 S. & A. 2085*

Map No. 16 Sec. 9 Twp. 23 R. 11Well No. 2 TippennyJ. B. Simmons Company

Contractor

FIRST REPORTS

Ft. from N. Line

300 Ft. from S. Line300 Ft. from E. Line

Ft. from W. Line

SECTION PLAT

Location

Rig up Timber

Drilling and Remarks:

RECORD

Cased _____ in., _____ ft.

Sand _____

Gas _____

Oil _____

Total Depth _____

PRODUCTION

1st 24 hrs. Nat. _____

1st 24 hrs. after shot _____

Gas _____ Cu. Ft.

Dry Hole _____

Abandoned _____

Date

JUL 10 1925

CHAS. L. SHERWOOD

192

Scout

K16 **KANSAS** Sec. 9 Twp. 23 R. 11

Well No. 2 Liffany
D. J. Dimmond Company

Contractor

COMPLETED

SECTION PLAT

_____ Ft. from N. Line

300 Ft. from S. Line

300 Ft. from E. Line

_____ Ft. from W. Line

ABANDONED

Location _____

Rig up _____

Drilling and Remarks:

Dry & shot

D.D. 2085'

RECORD

Cased _____ in., _____ ft.

Sand _____

Gas _____

Oil _____

Total Depth 2085'

PRODUCTION

1st 24 hrs. Nat. _____

1st 24 hrs. after shot _____

Gas _____ Cu. Ft.

Dry Hole ☒

Abandoned ☒

Date

NOV 19 1925

CHAS. L. SHERWOOD

192

Scout