


Map No. _____ Sec. 32 Twp. 26 R. 5

Well No. 2 Mill Farm _____
Carter S. W. Company _____

NORTH

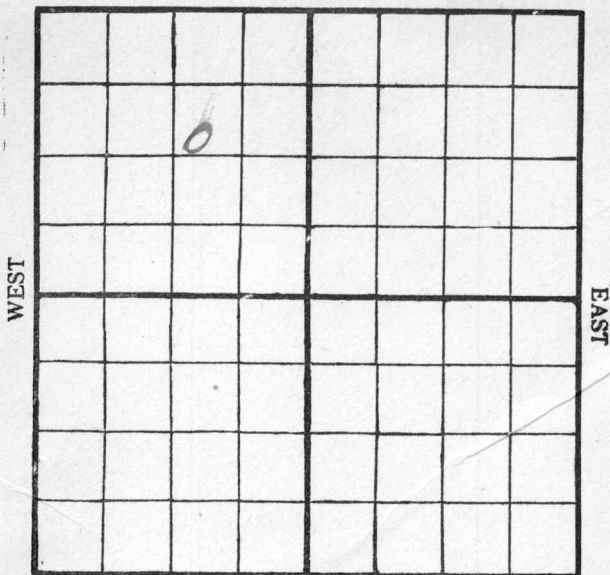

SOUTH

Location _____

Rig Up _____

Drilling Remarks:

Drilling Remarks:

RECORD

Cased _____ in. _____ ft.

Sand _____

Gas _____

Oil _____

Total Depth _____

PRODUCTION

1st 24 hrs. Nat. _____

1st 24 hrs. after shot _____

Gas _____ cu. ft.

Dry Hole _____

Abandoned _____


Map No. K14 Sec. 32 Twp. 26 R. 5

Well No. 2 Hill Farm

Carter Company

NORTH

WEST

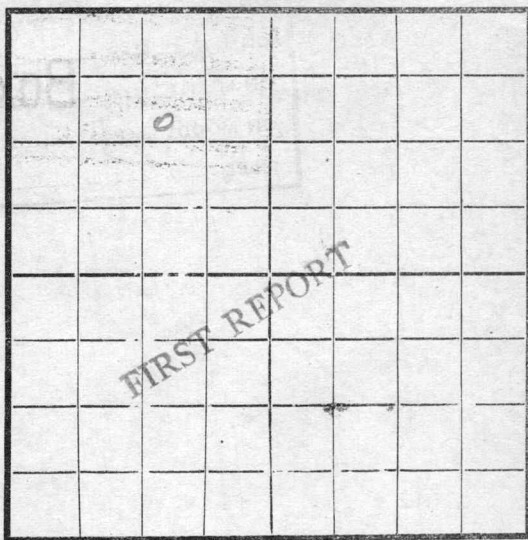

EAST

SOUTH

Location -----

Rig Up -----

Drilling and remarks

Spud

Company Tools

RECORD

Cased ----- in. ----- Ft.

Sand -----

Gas -----

Oil -----

Total Depth -----

PRODUCTION

1st 24 hrs. Nat. -----

1st 24 hrs. after shot -----

Gas ----- Cu. Ft.

Dry Hole -----

Abandoned -----

Date

27, 1915 Pyke Scout

27


Map No. K14 Sec. 32 Twp. 26 R. 5

Well No. 2 Skill Farm

Carter Company

NORTH

WEST

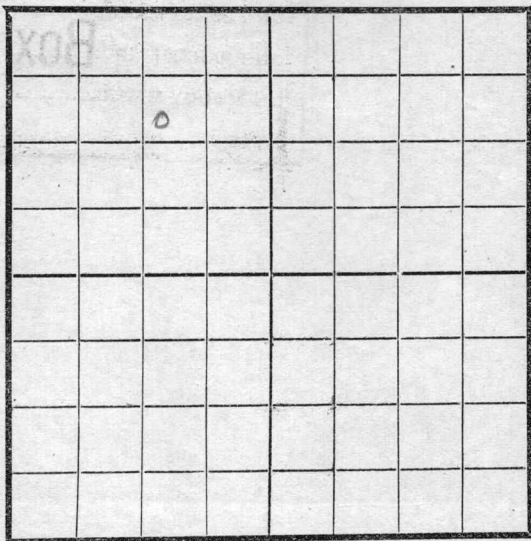

EAST

SOUTH

Location -----

Rig Up -----

Drilling and remarks

*Company
Tools*

RECORD

Cased ----- in. ----- Ft.

Sand -----

Gas -----

Oil -----

Total Depth -----

PRODUCTION

1st 24 hrs. Nat. -----

1st 24 hrs. after shot -----

Gas ----- Cu. Ft.

Dry Hole -----

Abandoned -----

Date


2/8, 1918 Cyle Scout

1/22

1002 K14
 Map No. _____ Sec. 32 Twp. 26 R. 5
 Well No. 2 Mill Farm
50, 71 9 Carter Company

NORTH

WEST

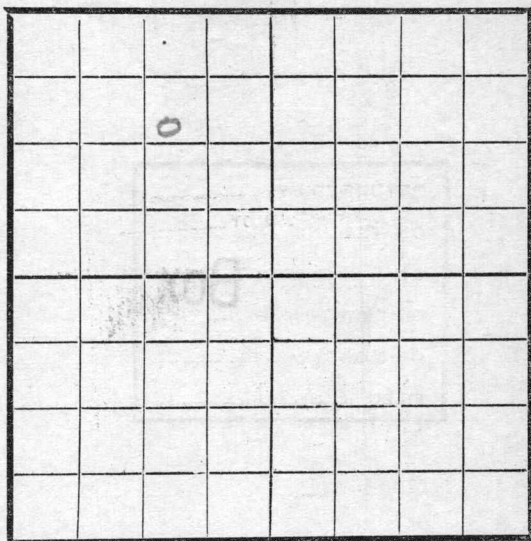

EAST

SOUTH

Location _____
 Rig Up _____
 Drilling and remarks

400'

RECORD

Cased _____ in. _____ Ft.
 Sand _____
 Gas _____
 Oil _____
 Total Depth _____

PRODUCTION


1st 24 hrs. Nat. _____
 1st 24 hrs. after shot _____
 Gas _____ Cu. Ft.
 Dry Hole _____
 Abandoned _____

Date

3/6, 1915 F D Tyb Scout

1004 K14 Map No. 32 Sec. 26 Twp. 5 R. 2
 Well No. 2 Hill Farm
S. M. & Carter Company

NORTH

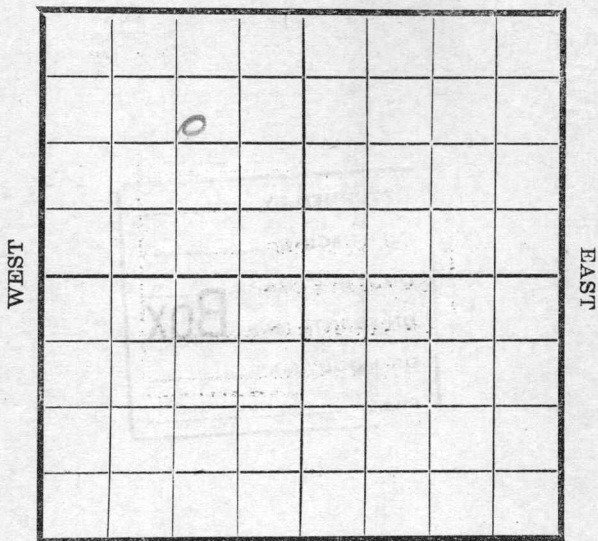

SOUTH

Location -----
 Rig Up -----
 Drilling and remarks

590'

RECORD

Cased ----- in. ----- Ft.
 Sand -----
 Gas -----
 Oil -----
 Total Depth -----

PRODUCTION

1st 24 hrs. Nat. -----
 1st 24 hrs. after shot -----
 Gas ----- Cu. Ft.
 Dry Hole -----
 Abandoned -----

Date


3/11, 1918 Pyle Scout

Map No. 104 H 14 Sec. 32 Twp. 26 R. 5

Well No. 2 Hill Farm
W. H. & Carter Company

NORTH

WEST

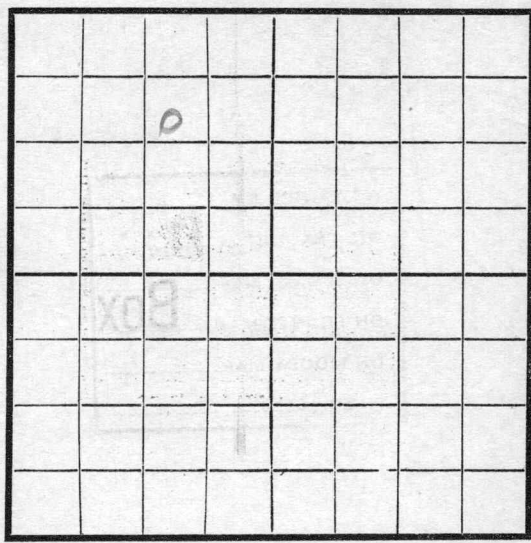

EAST

SOUTH

Location -----
 Rig Up -----
 Drilling and remarks

RECORD

Cased ----- in. ----- Ft.
 Sand -----
 Gas -----
 Oil -----
 Total Depth -----

PRODUCTION

1st 24 hrs. Nat. -----
 1st 24 hrs. after shot -----
 Gas ----- Cu. Ft.
 Dry Hole -----
 Abandoned -----


Date

3/22, 1918 W. H. & Carter Scout

Map No. _____ Sec. 32 Twp. 26 R. 5
 Well No. 20 Hill Farm _____
Carter S. H. Company _____

NORTH

WEST

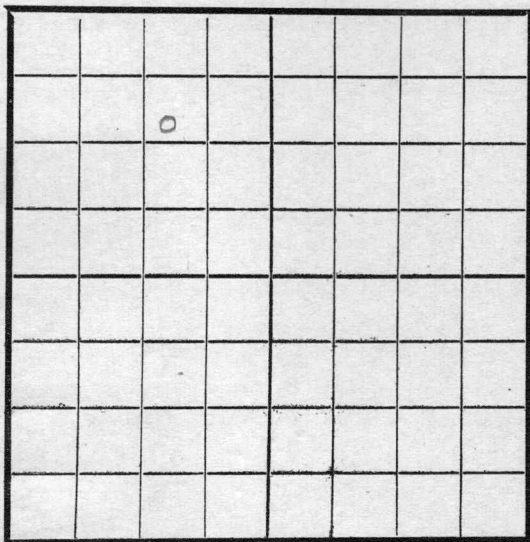

EAST

SOUTH

Location _____

Rig Up _____

Drilling and remarks

2140

RECORD

Cased _____ in. _____ Ft.

Sand _____

Gas _____

Oil _____

Total Depth _____

PRODUCTION

1st 24 hrs. Nat. _____

1st 24 hrs. after shot _____

Gas _____ Cu. Ft.

Dry Hole _____

Abandoned _____

Date


4/8, 1913

Oy u Scout

Map No. _____ Sec. 37 Twp. 26 R. 5
 Well No. 2 Hill Farm _____
Carter D.H. Company

NORTH

WEST

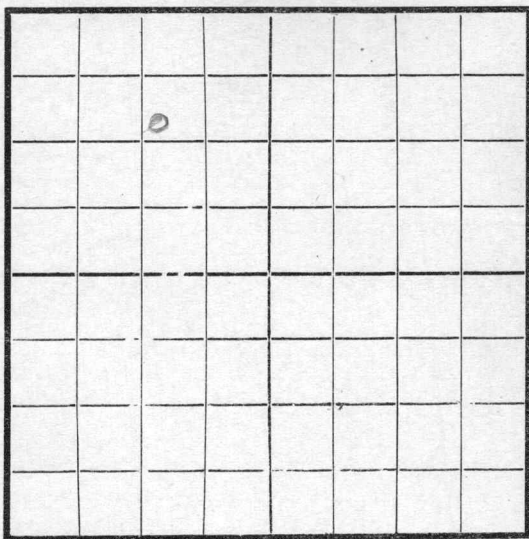

EAST

SOUTH

Location _____
 Rig Up _____
 Drilling and remarks

2359

RECORD

Cased _____ in. _____ Ft.
 Sand _____
 Gas _____
 Oil _____
 Total Depth _____

PRODUCTION

1st 24 hrs. Nat. _____
 1st 24 hrs. after shot _____
 Gas _____ Cu. Ft.
 Dry Hole _____
 Abandoned _____


Date

4/8, 1918 Cyle Scout

Map No. _____ Sec. 32 Twp. 26 R. 5Well No. 22 Hill Farm _____Carter & H. Company _____

NORTH

WEST

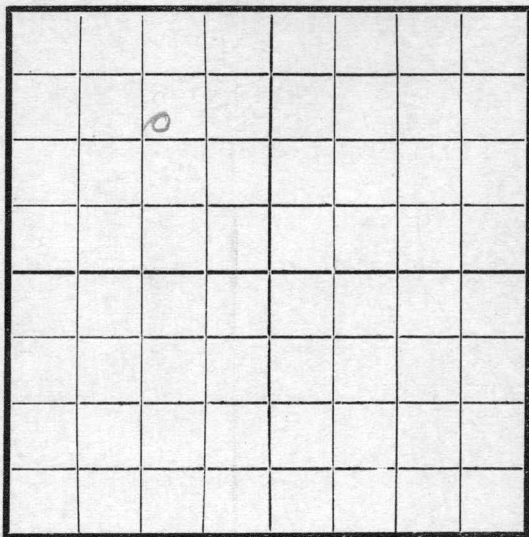

EAST

SOUTH

Location _____

Rig Up _____

Drilling and remarks

RECORD

Cased _____ in _____ Ft.

Sand _____

Gas _____

Oil _____

Total Depth _____

PRODUCTION

1st 24 hrs. Nat. _____

1st 24 hrs. after shot _____

Gas _____ Cu. Ft.

Dry Hole _____

Abandoned _____


Date

3/5, 1915 Oyle Scout25

Map No. _____ Sec. 32 Twp. 26 R. 5
Well No. 2 Hill Farm _____
Carter D. H. Company _____

NORTH

WEST

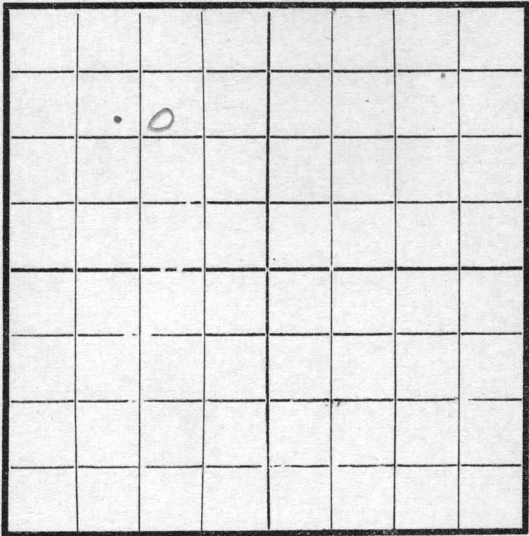

EAST

SOUTH


	RECORD
Location _____	Cased _____ in _____ Ft.
Rig Up _____	Sand _____
Drilling and remarks	Gas _____
<u>2415'</u>	Oil _____
	Total Depth _____
	PRODUCTION
	1st 24 hrs. Nat. _____
	1st 24 hrs. after shot _____
	Gas _____ Cu. Ft.
	Dry Hole _____
	Abandoned _____

Date 4/8/17, 1918 Oyle Scout

Map No. _____ Sec. 32 Twp. 26 R. 5Well No. 2 Hill Farm _____Carter & D. H. Company _____

NORTH

WEST

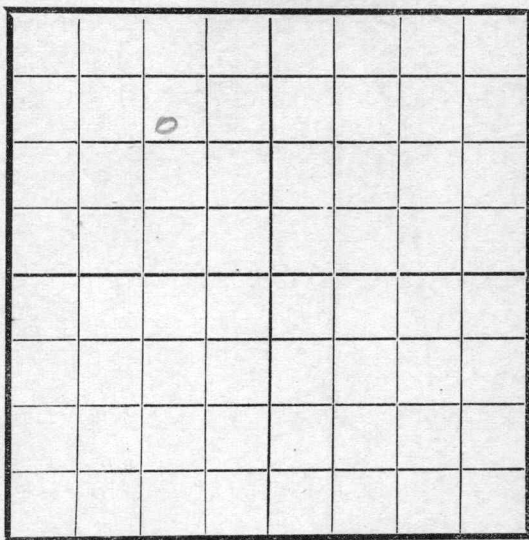

EAST

SOUTH

Location _____

Rig Up _____

Drilling and remarks

2550'

RECORD

Cased _____ in. _____ Ft.

Sand _____

Gas _____

Oil _____

Total Depth _____

PRODUCTION

1st 24 hrs. Nat. _____

1st 24 hrs. after shot _____

Gas _____ Cu. Ft.

Dry Hole _____

Abandoned _____

Date

4/24, 1918 C. H. Kyle Scout

Map No. 1114 Sec. 32 Twp. 26 R. 5Well No. 5 Hill Farm
D. H. Brown & Carter Company

NORTH

WEST

EAST

SOUTH

Location 1070-NRig Up 250-E

Drilling and remarks

fishing
@
2375'

RECORD

Cased _____ in. _____ Ft.

Sand _____

Gas _____

Oil _____

Total Depth _____

PRODUCTION

1st 24 hrs. Nat. _____

1st 24 hrs. after shot _____

Gas _____ Cu. Ft.

Dry Hole _____

Abandoned _____

Date

10/8, 1918 Pyle Scout