KANSAS Greenwood


FORM 51 10M 7-48 PETROL

Section 4 Township 23 Range 11-E

Well No. #1 Meyer

Company Jones Construction

Miscellaneous

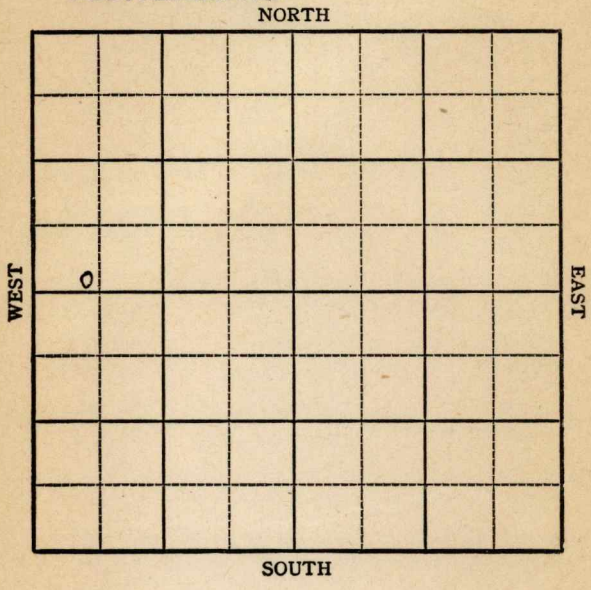

FORM 252-A
5M 10-48 PETROL

KANSAS


Greenwood

Sec. 4 Twp. 23 R. 11E ✓

Well No. #1 Meyer Farm

Jones Construction Company

Miscellaneous

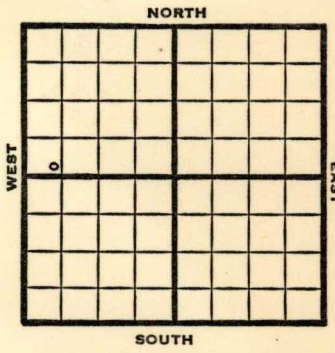

_____ Ft. from N. Line

100' Ft. from S. Line

_____ Ft. from E. Line

500' Ft. from W. Line

SW NW

1948	REPORT
12/1	Bartl. 1917' 5" @ 1917' TD 2027'
12/6	"
12/15	TD 2027' Bart 1987' Aband. ABANDONED

Form 26 200 Bks. 9-48 Petrol

Kansas

Miscellaneous

Map No. _____ Sec. 4 Twp. 23 R. 11E


Well No. 1 Meyer

Jones Construction Company

FIRST REPORT Contractor

SW NW

SECTION PLAT

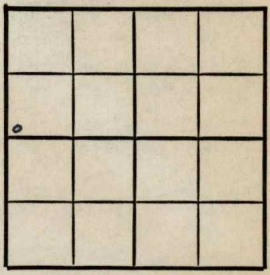

_____ Ft. from N. Line

100 Ft. from S. Line

_____ Ft. from E. Line

500 Ft. from W. Line

Greenwood County

Location _____

Rig up _____

Drilling and Remarks:

Bartl. 1917

5" @ 1917

TD 2027

RECORD

Cased _____ in., _____ ft.

Sand _____

Gas _____

Oil _____

Total Depth _____

PRODUCTION

1st 24 hrs. Nat. _____

1st 24 hrs. after shot _____

Gas _____ Cu. Ft.

Dry Hole _____

Abandoned _____

Date

DEC 1 1948 19

S. J. LEWIS Scout

Form 26 200 Bks. 9-48 Petrol

Kansas

Miscellaneous

Map No. 16 Sec. 4 Twp. 23 R. 11E


Well No. 1 Meyer

Jones Construction Company

ABANDONED Contractor

SW NW

SECTION PLAT

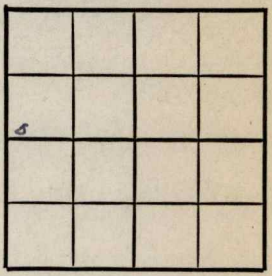

____ Ft. from N. Line

100 Ft. from S. Line

____ Ft. from E. Line

500 Ft. from W. Line

Greenwood County

Location

Rig up

Drilling and Remarks:

Bar 1957

RECORD

Cased ____ in., ____ ft.

Sand

Gas

Oil

Total Depth 2027

PRODUCTION

1st 24 hrs. Nat.

1st 24 hrs. after shot

Gas ____ Cu. Ft.

Dry Hole

Abandoned

Date

DEC 15 1948 19

S. J. LEWIS Scout