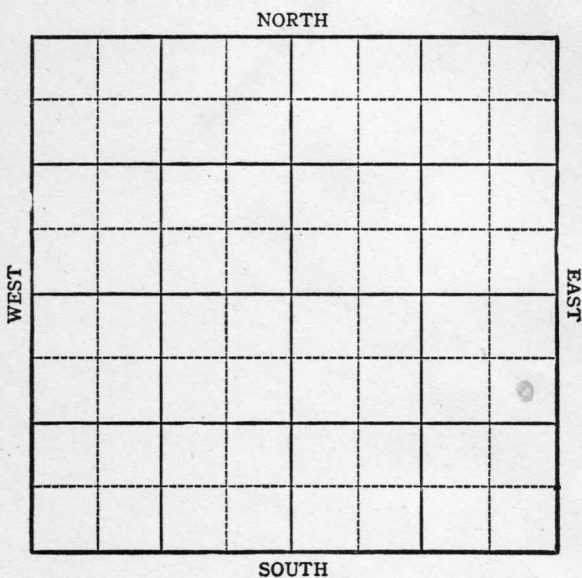


FORM 51 5M BRIX

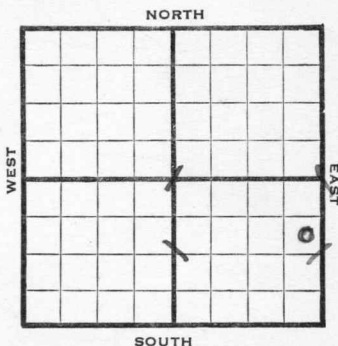
Section 24 Township 29 Range 14 WWell No. #1, M. AndrewsCompany Carter Oil

KANSAS

Pratt

Sec. 24 Twp. 29 R. 14WWell No. #1, M. Andrews FarmCarter Company

Coats

990 Ft. from N. Line Ft. from S. Line330 Ft. from E. Line Ft. from W. LineElev. 1961

1944

REPORT

5/31	Location
6/7	"
6/15	10" @ 535 Drlg. 1595
6/21	Drlg. 2625
6/28	Drlg 3100
7/12	No Viola Lans 3927 Simp 4395 TD 4406 Run csg.
7/19	6" @ 4394 RUST
7/26	Simpson 4393 Corrected TD 4404 flow 25 oil per hr 2 hrs.
8/2	TD 4431 swb 37 oil in 4 hrs thru tbq.
8/9	30 qts 4399-4427 C0
8/16	" " " " "
8/23	" " " " "
8/30	" " " " "
9/8	Pump 30 oil per hr 3 hrs.
9/13	" " " " " " "
9/21	" " " " " " "
9/27	Simp 4393 6" @ 4394 20 qts 4399-4407 10 qts 5523-27 Pump 423 Pot. Grav. 40.9 TD 4431

COMPLETED

Pool Name Coats

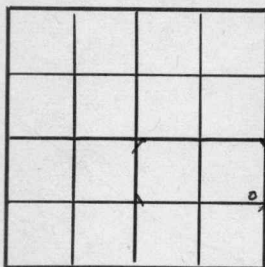
KANSAS
 Map No. 92 Sec. 24 Twp. 29 R. 14W

Well No. 1 M. Andrews
Carter Company

FIRST REPORT Contractor

SE NE SE

SECTION PLAT

990 Ft. from N. Line Ft. from S. Line330 Ft. from E. Line Ft. from W. LinePratt CountyLocation XRig up

Drilling and Remarks:

RECORD

Cased in., ft.Sand Gas Oil Total Depth

PRODUCTION

1st 24 hrs. Nat. 1st 24 hrs. after shot Gas Cu. Ft.Dry Hole Abandoned

Date

MAY 31 1944 19

S. J. LEWIS Scout

Pool Name Coats PoolMap No. KANSAS Sec. 24 Twp. 29 R. 14WWell No. 1 M. AndrewsCarter CompanyCOMPLETED

Contractor

SE NE SE

SECTION PLAT

990 Ft. from N. Line Ft. from S. Line330 Ft. from E. Line Ft. from W. LinePratt CountyLocation Rig up

Drilling and Remarks:

Surf 4393
6" @ 4394
209 ft 4399-4407
10 " 4423-27
Pump 423 P.X
40 ft

RECORD

Cased in., ft.Sand Gas Oil Total Depth 4431

PRODUCTION

1st 24 hrs. Nat. 1st 24 hrs. after shot Gas Cu. Ft.Dry Hole Abandoned

Date

SEP 27 1944 19S. J. LEWIS Scout