

Section 10 Township 27 Range 2 EWell No. # 1 Stotz *(Stoltz)*Company A. D. Allison

NORTH

							0

WEST

EAST

SOUTH

Sedgwick

KANSAS

Sec. 10 Twp. 27 R. 2 E

Well No. # 1 Stotz Farm

A. D. Allison Company

Contractor

Wildcat


330 Ft. from N. Line

Ft. from S. Line

330 Ft. from E. Line

Ft. from W. Line

NE NE NE

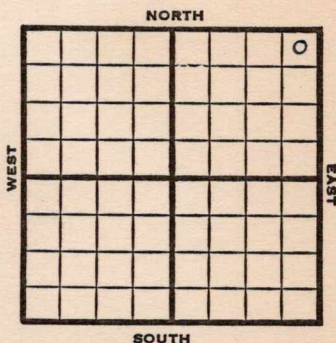

1951

Elev. 1381'

REPORT

4/11

8" @ 104

6/13

Spud 5-5-51

Oil Well TD 3316

8" @ 104'

KC 2443

Miss 2906

Kh 3114

Misenor 3200

DST 3200-02 opn $\frac{1}{2}$ hr.

Rec. 640' wtr

Viola 3201 Simp. 3222

DST 3251-65 opn $\frac{1}{2}$ hr Rec. 920' wtr

DST 3293-96 opn 40 min Rec. 90' mud

DST 3290-3312 opn 30 min. Rec 200'

oil 100' ocm Arb. 3313 TD 3316

5" @ 3314 3/3308-09 3/3300-02

FU 700' oil 2 hr. P/60 bo 8hr

Comp. 112 bopd

COMPLETED

County Sedgwick State KansasSec. 10 (Blk. 27 (Sur. 2E Map No. 2E)
(Twp.) (Rge.)Operator A. D. AllisonWell No. 1 Farm StotzElev. _____ Location NE NE NE

330 Ft. From N Line NE330 Ft. From E Line Quarter1st. Report APR 11 1951


Completion _____

Remarks _____

Spudding Date _____

Drlg. Data Wildcat8" @ 104

J. E. TYRA

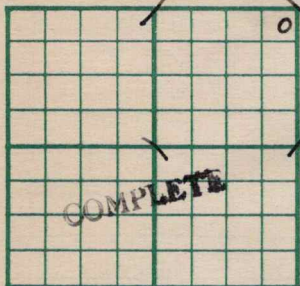County Sedgwick State KansasSec. 10 (Blk.
Twp.) 27 (Sur.
Rge.) 2E Map No.Operator A. D. AllisonWell No. 1 Farm StotzElev. 1381 Location NE NE NE330 Ft. From N Line NE330 Ft. From E Line Quarter

1st. Report

Completion JUN 13 1951Remarks WildcatSpudding Date 5-5-51Drilg. Data Oil well TD 33168" @ 104 KC 2443 Miss. 2906Kh. 3114 Misenor 3200 DST 3200-02 open $\frac{1}{2}$ hr. Rec. 640' waterViola 3201 Simp. 3222 DST 3251-65 open $\frac{1}{2}$ hr. Rec. 920' waterDST 3293-96 open 40 min. Rec. 90'mud DST 3290-3312 open 30 min.Rec. 200' oil 100' ocm Arb. 3313TD 3316 5" @ 3314 3/ 3308-093/ 3300-02 FU 700' oil 2 hr.P/ 60 bo 8 hr. Comp. 112 bopd

J. E. TYRA