
Form 51 5M 7-22 9573

Map No. _____ Sec. 5 Twp. 23 R. 11

Well No. 3 Seely Farm

White Eagle & Nelson Company

NORTH

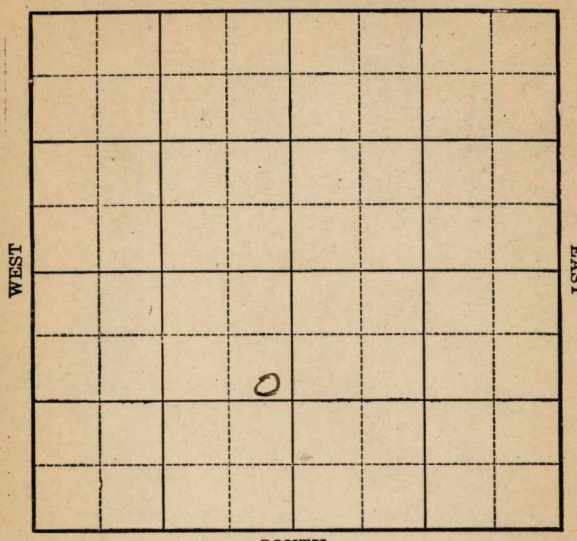

FIRST REPORT

Location _____

Drilling Remarks:

Rig up _____

Drilling Remarks:

RECORD

Cased _____ in. _____ ft.

Sand _____

Gas _____

Oil _____

Total Depth _____

PRODUCTION

1st 24 hrs Nat. _____

1st 24 hrs. after shot _____

Gas _____ cu. ft.

Dry Hole _____

Abandoned _____

Form 252A 5M 8-21 PALACE-TULSA 6835

Map No. _____ Sec. 5 Twp. 23 R. 11

Well No. 3 Seely Farm


White Eagle & Nelson Company

1120 Ft. from N. Line

_____ Ft. from S. Line

200 Ft. from E. Line

_____ Ft. from W. Line

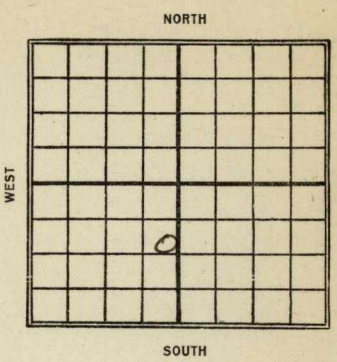

Date 1923	REPORT
1/6	Dlg. 265'
1/26	Sand 1916-58- Shot 160 qts. 400 Bbls. J.D. 1963'

Form 26—1M—4-19—Mid-West

Map No. KANSAS 16 Sec. 3 Twp. 23 R. 11

Well No. 3 Kelly

White Eagle & Nelson Company

Contractor

FIRST REPORT


1120 Ft. from N. Line

Ft. from S. Line

200 Ft. from E. Line

Ft. from W. Line

SECTION PLAT

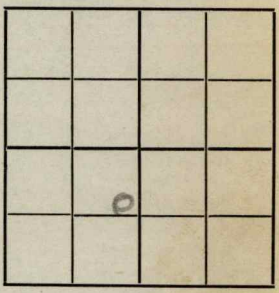

Location

Rig up

Drilling and Remarks:

Rig up

265

RECORD

Cased in., ft.

Sand

Gas

Oil

Total Depth

PRODUCTION

1st 24 hrs. Nat.

1st 24 hrs. after shot

Gas Cu. Ft.

Dry Hole

Abandoned

Date

JAN 6 1923

191

M. A. BENEAR

Scout

Form 26—1M—4-19—Mid-West

KANSAS

Map No. _____ Sec. 5 Twp. 23 R. 11


Well No. 3 Seely

White Eagle Company

_____ Contractor

COMPLETED

SECTION PLAT

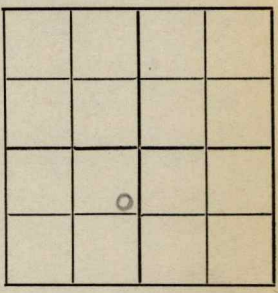

1120 Ft. from N. Line

_____ Ft. from S. Line

200 Ft. from E. Line

_____ Ft. from W. Line

Location _____

Rig up _____

Drilling and Remarks:

sand 1916 / 1958

shot 160 qts

400 lbs.

RECORD

Cased _____ in., _____ ft.

Sand _____

Gas _____

Oil _____

Total Depth 1963

PRODUCTION

1st 24 hrs. Nat. _____

1st 24 hrs. after shot _____

Gas _____ Cu. Ft.

Dry Hole _____

Abandoned _____

Date

JAN 26 1923

_____ 191____.

M. A. BENEAR

_____ Scout