


KANSAS

Sedgwick

Section 11 Township 27 Range 2EWell No. #1 FaulkCompany A. D. Allison

NORTH

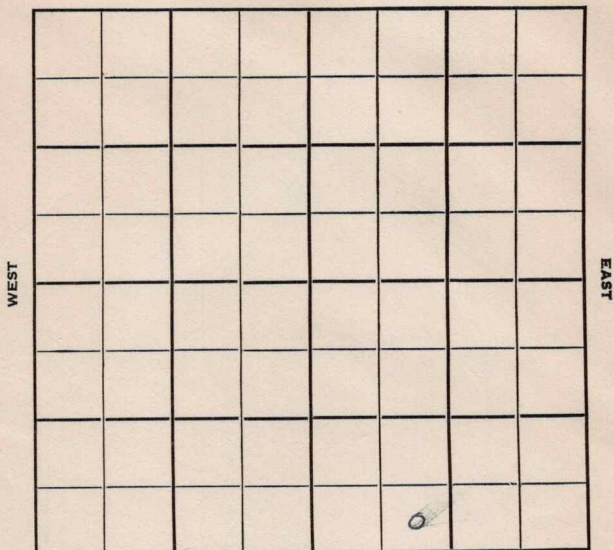

SOUTH

Sedgwick

KANSAS

Sec. 11 Twp. 27 R. 2 E ✓

Well No. # 1 Faulk Farm

A. D. Allison Company

Allison Contractor


Wildcat
Ft. from N. Line

330 Ft. from S. Line

 Ft. from E. Line

990 Ft. from W. Line

SE SW SE

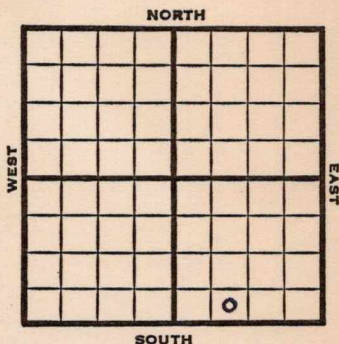

1951

Elv. 1330' REPORT

3/7

R U R

5/23

Spud 3-6-51
Oil Well TD 3288
8" @ 125
Miss 2840 Viola 3137
Simp. 3157' TD 3165
DST 3160-65 opn ½ hr.
Rec. 450' sw DST 3250-57 opn ½ hr
Rec. 190' ocm 2280' free oil 90' ocm
Arb. 3245 5" @ 3288 TD 3288
12/3247-51 FU 500' oil 250 A
S/20 boph F/55 bopd Comp. 144 bopd

COMPLETED

County **Sedgwick** State **Kansas**Sec. **11** (^{Blk.}
Twp.) **27** (^{Sur.}
Rge.) **2E** Map No.Operator **A. D. Allison**Well No. **1** Farm **Faulk**Elev. Location **SE SW SE**

FIRST REPORT

0

330 Ft. From **S** Line **SE****990** Ft. From **W** Line Quarter1st. Report **MAR 7 1951**

Completion

Remarks

Allison - Contr.

Spudding Date

Drlg. Data **Wildcat****RUR**

J. E. TYRA

