


Section 11 Township 27 Range 2 EWell No. # 2 FaulkCompany A. D. Allison et al

NORTH

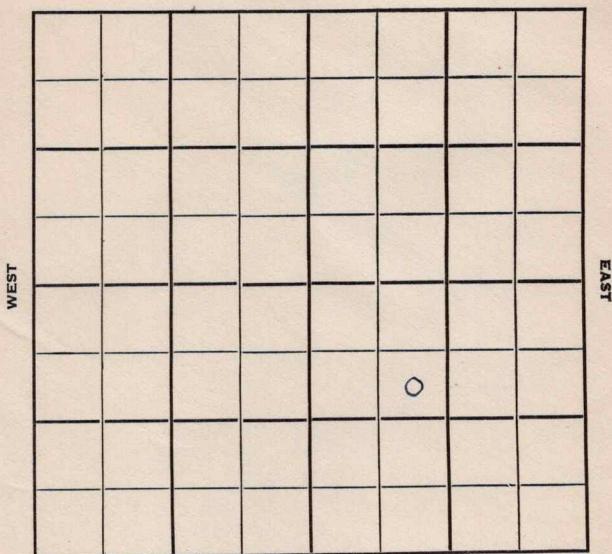

SOUTH

Sedgwick

KANSAS

Sec. 11 Twp. 27 R. 2 E ✓✓

Well No. # 2 Faulk Farm

A. D. Allison et al Company

Contractor


990 Ft. from N. Line

Ft. from S. Line

Ft. from E. Line

990 Ft. from W. Line

SE NW SE

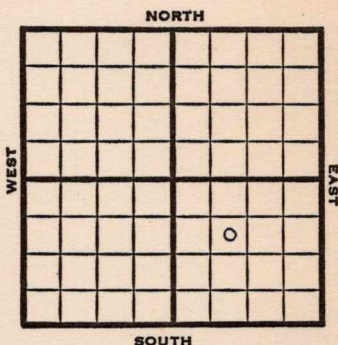

1951

Elev. 1345'

REPORT

4/18

Location

5/9

Spud 4-18-51

D&A TD 3310

8" @ 210

Miss 2863 Kinderhook 3076

Viola 3164 Simp. dol. 3184

Simp sd 3190 Arb. 3290

TD 3310'

D&A

ABANDONED

1951

O. W. D. D.

8/1

OTD 3310 DD 3450

9/5

SWD Well TD 4035

Aband.


OTD 3310 DD 3450 Granite wash 4015

TD 4035

5" @ 3340

Comp. for SWD well

COMPLETED
ABANDONED

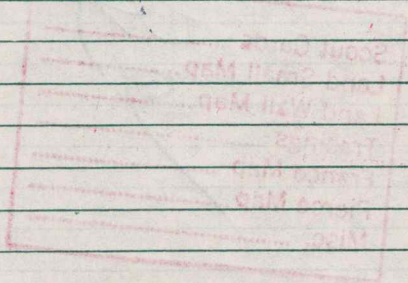County Sedgwick State KansasSec. 11 (Blk.) 27 (Sur.) 2E Map No.Operator A. D. Allison etal.Well No. 2 Farm FaulkElev. 1345 Location SE NW SE990 Ft. From N Line SE990 Ft. From W Line Quarter1st. ReportCompletion MAY 9 1951RemarksSpudding Date 4-18-51Drlg. Data D & A TD 33108" @ 210 Miss. 2863 Kinderhook 3076Viola 3164 Simp. dol. 3184 Simp. sd. 3190Arb. 3290 TD 3310D & A

J. E. TYRA

County Sedgewick State Kansas

Sec. 11 (Blk. 27 (Sur. 2E) Map No.

Operator A. D. Allison

Well No. 2 Farm Faulk

Elev.	Location	SE	NW	SE

FIRST REPORT

990 Ft. From N Line SE

990 Ft. From W Line Quarter

1st. Report AUG 1 1951

Completion

Remarks: OWDD

Spudding Date _____

Drlg. Data

OTD 3310 DD 3450

J. E. TYRA

County Sedgwick State Kansas
 Sec. 11 (Blk.) 27 (Sur.) 2E Map No. _____
 Operator A. D. Allison
 Well No. 2 Farm Faulk
 Elev. _____ Location SE NW SE



990 Ft. From N Line SE
990 Ft. From W Line Quarter
 1st. Report _____
 Completion SEP 5 1951
 Remarks OWDD

Spudding Date _____

Drig. Data SWD well TD 4035
OTD 3310 DD 3450 Granite wash 4015
TD 4035 5" @ 3340 Comp. for SWD well