


Map No. _____ Sec. 32 Twp. 76 R. 5Well No. 7 Brown Farm
Monitor Oil Co. Company

NORTH

WEST

EAST

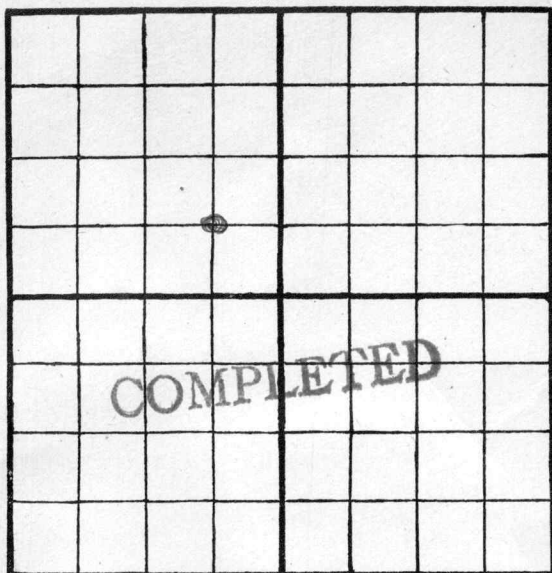

SOUTH

Location _____

Rig Up _____

Drilling Remarks:

Drilling Remarks:

40 Brelsford 2725-27506/14/18

RECORD

Cased _____ in. _____ ft.

Sand _____

Gas _____

Oil _____

Total Depth _____

PRODUCTION

1st 24 hrs. Nat. _____

1st 24 hrs. after shot _____

Gas _____ cu. ft.

Dry Hole _____

Abandoned _____

1004 A14 Map No. Sec. 32 Twp. 26 R. 5

Well No. 7 Brown Farm

Monitor Oil Company

NORTH

WEST

EAST

SOUTH

FIRST REPORT

Location -----

Rig Up ✓ -----

Drilling and remarks

RECORD

Cased ----- in. ----- Ft.

Sand -----

Gas -----

Oil -----

Total Depth -----

PRODUCTION

1st 24 hrs. Nat. -----

1st 24 hrs. after shot -----

Gas ----- Cu. Ft.

Dry Hole -----

Abandoned -----

Date


5/2, 1918

Cyr Scout

Map No. _____ Sec. 32 Twp 26 R. 5
Well No. 7 Brown Farm _____
Monitor Oil Company _____

NORTH

WEST

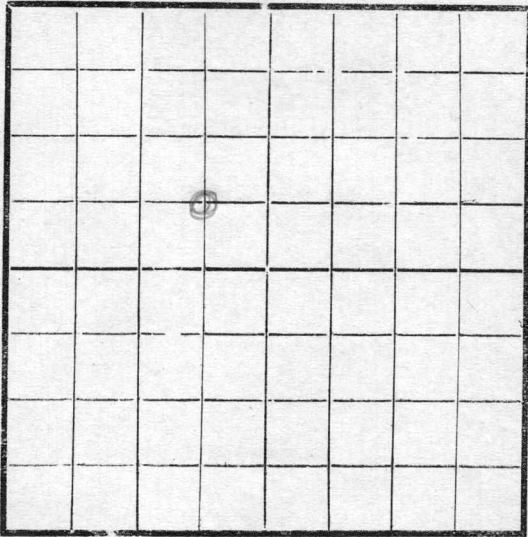

EAST

SOUTH

RECORD	
Location _____	Cased _____ in. _____ Ft.
Rig Up _____	Sand _____
Drilling and remarks	Gas _____
<u>21. R. to</u>	Oil _____
<u>720'</u>	Total Depth _____
	PRODUCTION
	1st 24 hrs. Nat. _____
	1st 24 hrs. after shot _____
	Gas _____ Cu. Ft.
	Dry Hole _____
	Abandoned _____


Date 5/8, 1918 Dyer Scout

Map No. _____ Sec. 32 Twp. 26 R. 5

Well No. 7 Brown Farm _____
Monitor Oil Company _____

NORTH

WEST

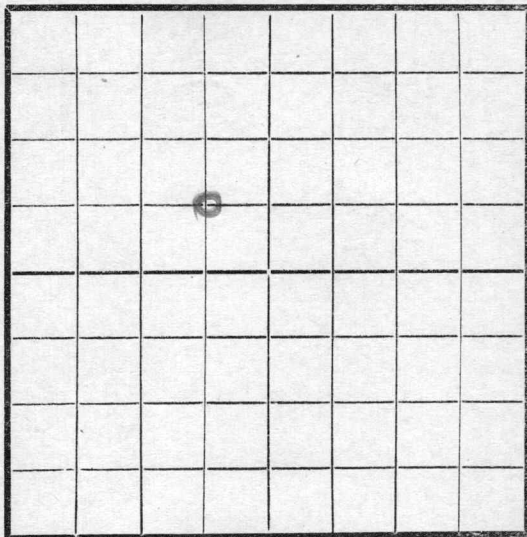

EAST

SOUTH

Location _____

Rig Up _____

Drilling and remarks

1000'

RECORD

Cased _____ in. _____ Ft.

Sand _____

Gas _____

Oil _____

Total Depth _____

PRODUCTION

1st 24 hrs. Nat. _____

1st 24 hrs. after shot _____

Gas _____ Cu. Ft.

Dry Hole _____

Abandoned _____


Date

5/14, 1918 Pyle Scout

Map No. _____ Sec. 32 Twp. 26 R. 5Well No. 7 Brown Farm _____Moniton Oil Company _____

NORTH

WEST

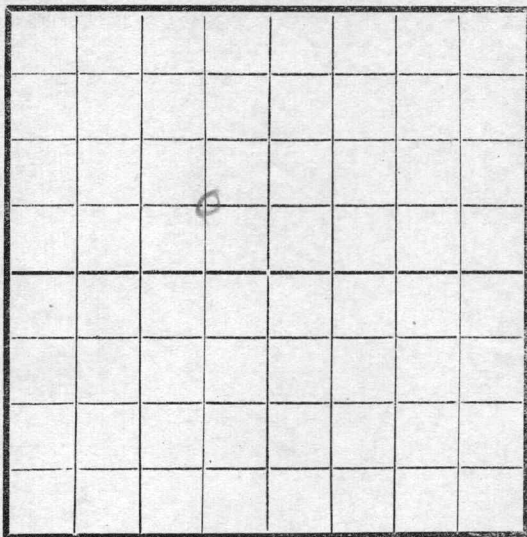

EAST

SOUTH

Location _____

Rig Up _____

Drilling and remarks

1850'

RECORD

Cased _____ in. _____ Ft.

Sand _____

Gas _____

Oil _____

Total Depth _____

PRODUCTION

1st 24 hrs. Nat. _____

1st 24 hrs. after shot _____

Gas _____ Cu. Ft.

Dry Hole _____

Abandoned _____

Date

5/8, 1918 Cyle Scout22

Map No. _____ Sec. 32 Twp. 26 R. 5Well No. 7 BrownMonitor Oil Company

Contractor _____

NORTH

WEST

EAST

SOUTH

Location _____

Rig up _____

Drilling and Remarks:

2200'

RECORD

Cased _____ in., _____ ft.

Sand _____

Gas _____

Oil _____

Total Depth _____

PRODUCTION

1st 24 hrs. Nat. _____

1st 24 hrs. after shot _____

Gas _____ Cu. Ft.

Dry Hole _____

Abandoned _____

Date

5/28 191 8 Oyle Scout

Map No. _____ Sec. 32 Twp. 26 R. 5Well No. 7 Brown

Company _____

Contractor _____

NORTH

WEST

EAST

SOUTH

Location _____

Rig up _____

Drilling and Remarks:

2600'

RECORD

Cased _____ in., _____ ft.

Sand _____

Gas _____

Oil _____

Total Depth _____

PRODUCTION

1st 24 hrs. Nat. _____

1st 24 hrs. after shot _____

Gas _____ Cu. Ft.

Dry Hole _____

Abandoned _____

Date

6/28
3Scout Cy h

1004 K 14 Map No. Sec. 32 Twp. 26 R. 5


Well No. 7 Brown
Monitor Oil Company

Contractor

NORTH

WEST

EAST

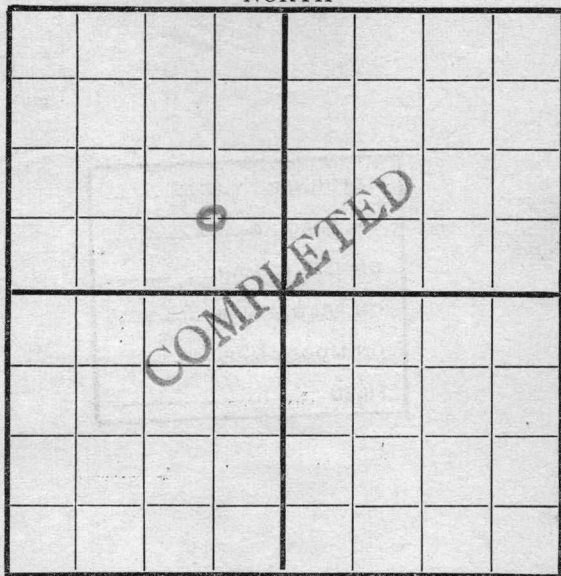

SOUTH

Location

Rig up

Drilling and Remarks:

Est 40 bbls

RECORD

Cased in., ft.

Sand 2725-2750

Gas

Oil

Total Depth

PRODUCTION

1st 24 hrs. Nat.

1st 24 hrs. after shot

Gas Cu. Ft.

Dry Hole

Abandoned

Date

1918

Scout