


Form 51-5M-3-35-Mid-West

Map No. **KANSAS** Sec. **12** Twp. **27** R. **2-E**
 Well No. **1-Ayers** Farm _____
Dickey Oil Company _____

NORTH

WEST

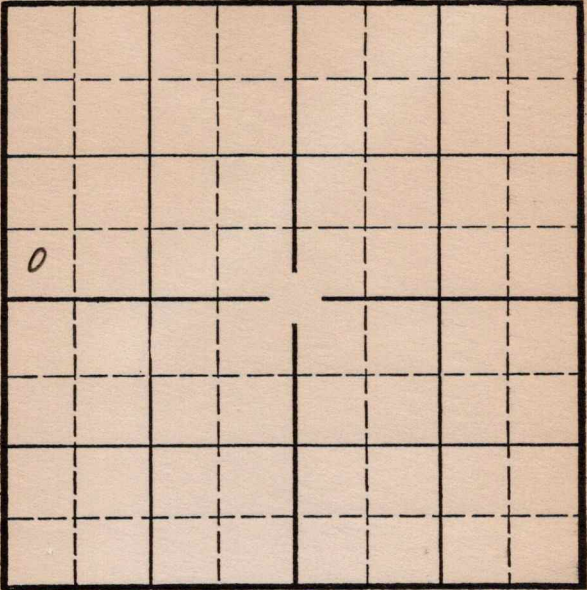

EAST

SOUTH

Location _____
 Drilling Remarks _____

Rig Up _____
 Drilling Remarks _____

RECORD

Cased _____ in. _____ ft.
 Sand _____
 Gas _____
 Oil _____
 Total Depth _____

PRODUCTION

1st 24 hrs. Nat. _____
 1st 24 hrs. after shot _____
 Gas _____ cu. ft. _____
 Dry Hole _____
 Abandoned _____

Map No. KANSAS Sec. 12 Twp. 27 R. 2E

Well No. 1- Ayers Farm

Dickey Oil Company


Ft. from N. Line

330 Ft. from S. Line

Ft. from E. Line

330 Ft. from W. Line

Elev. 1373

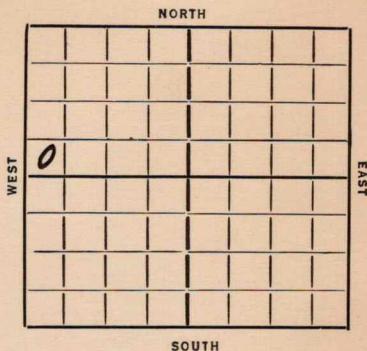

REPORT

1936	
3/11	Moving In
3/13	--
3/20	Rign.
3/27	--
4/2	T.D. 210' Running 15".
4/10	Fishing at 590'
4/16	Drlg. 1260'
4/23	Drlg. 2195'
4/30	Drlg. 2385'.
5/7	K.C. 2448' Fishing tools 2618'.
5/14	8" @ 2691'. Chat 2886'. HFW 2910-15'. S.D.
5/21	Drlg. 3040'.
5/28	Drlg. 3127'.
6/3/36	Misner # 3221'.
	H.F.W. 3226'.
	T.D. 3230'
	D & A
	ABANDONED

Map No. 12 Sec. 12 Twp. 27 R. 28Well No. 1-AyersHickey Oil Company

Contractor

FIRST REPORTS

SECTION PLAT

0			

Ft. from N. Line

330 Ft. from S. Line

Ft. from E. Line

330 Ft. from W. Line

Location

Rig up

Drilling and Remarks:

Moving in

RECORD

Cased.....in.,ft.

Sand.....

Gas.....

Oil.....

Total Depth.....

PRODUCTION

1st 24 hrs. Nat.....

1st 24 hrs. after shot.....

Gas.....Cu. Ft.

Dry Hole.....

Abandoned.....

Date

ORVAL MANNSCHRECK

3-11-36 192

Scout

Sedgwick

KANSAS

Map No. 12 Sec. 12 Twp. 27 R. 2EWell No. 1 Ryers

Company

Contractor

SECTION PLAT

0			

_____ Ft. from N. Line

330 Ft. from S. Line

_____ Ft. from E. Line

330 Ft. from W. Line

ABANDONED

Location _____

Rig up _____

Drilling and Remarks:

Miner 3221

NFW 3226

J & H

RECORD

Cased _____ in., _____ ft.

Sand _____

Gas _____

Oil _____

Total Depth 3230

PRODUCTION

1st 24 hrs. Nat. _____

1st 24 hrs. after shot _____

Gas _____ Cu. Ft.

Dry Hole _____

Abandoned _____

Date

JUN 3 1936

19

S. J. LEWIS

Scout