


Section 13 Township 27 Range 2E

Well No. 1 Fisher

Company J. P. Gaty

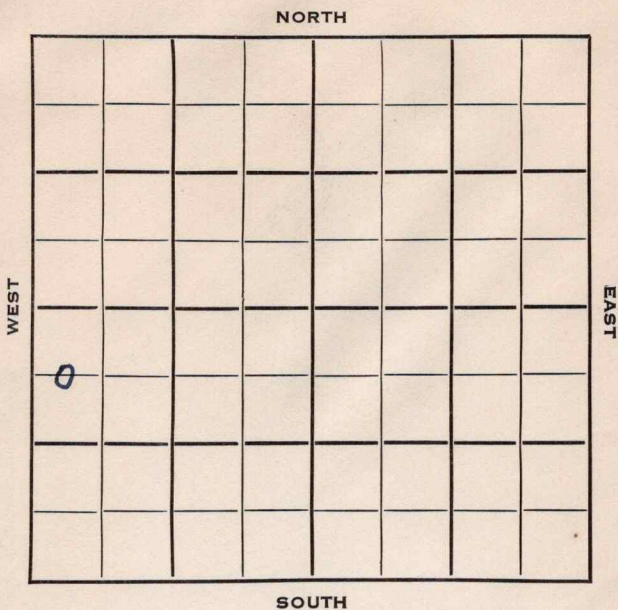

Sedgwick

KANSAS

SEC.	TWP.	R.
13	27	2 E

WELL NO. # 1 Fisher FARM

COMPANY J. P. Gaty

CONTRACTOR Morrison Drlg.

Minneha Pool


660 Ft. from N. Line

Ft. from S. Line

Ft. from E. Line

330 Ft. from W. Line

C W L NW SW

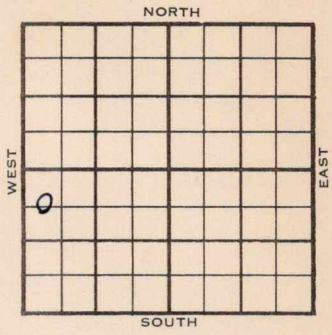

1954	ELEVATION	REPORT
	1322'	

3/31
4/14

BUR
Spud 3-29-54
D&A
TD 3306'
10" @ 80'
KC 2387', Marm. 2568', Miss 2844',
Kh. 3109', Chat sh 3158', Viola
3168', Simp dol. 3187', Simp sd 3193'
Arb. 3272'
TD ~~3306~~ 3306'
D&A

ABANDONED

