


Section 13 Township 27 Range 2E
 Well No. #1 Smith
 Company Eckland Drlg.

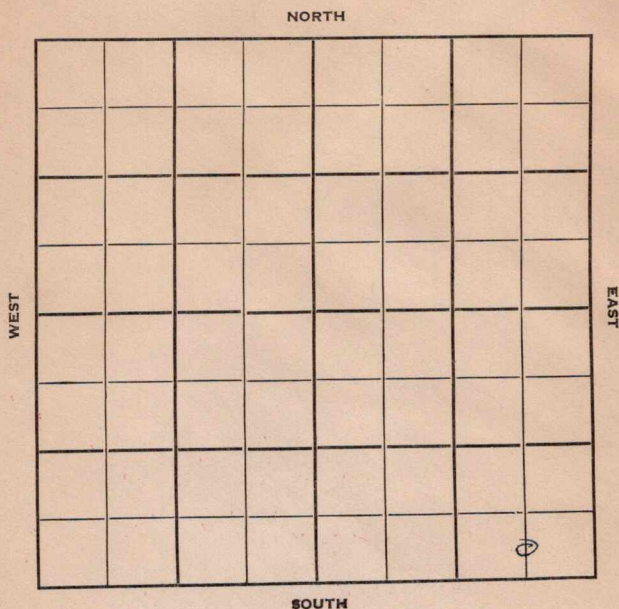

Sedgwick KANSAS

Sec. 13 Twp. 27 R. 2E

Well No. #1 Smith Farm

Eckland Drlg. Company

Eckland Drlg. Contractor

Wildcat

Ft. from N. Line

330'


Ft. from S. Line

660'

Ft. from E. Line

Ft. from W. Line

C S L SE SE

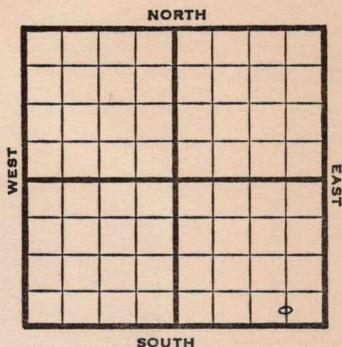

1950

Elev 1320'

REPORT

4/12 Spud 4-10-50

8" @ 105'

Drlg. 1370'

4/19 TD 2486'

8"@ 105'

KC 2372'

TD 2486'

D&A

Aband.

ABANDONED

Map No. _____ Sec. 13 Twp. 27 R. 2EWell No. 1 Smith

_____ Eckland Drlg. _____ Company

_____ Eckland Drlg. _____ Contractor


C S L S E S E

SECTION PLAT

_____ Ft. from N. Line

330 Ft. from S. Line660 Ft. from E. Line

_____ Ft. from W. Line

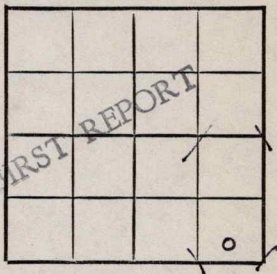

Sedgwick County

Location _____

Rig up _____

Drilling and Remarks:

Spud 4-10-50

8" @ 105

drlg. 1370

RECORD

Cased _____ in., _____ ft.

Sand _____

Gas _____

Oil _____

Total Depth _____

PRODUCTION

1st 24 hrs. Nat. _____

1st 24 hrs. after shot _____

Gas _____ Cu. Ft.

Dry Hole _____

Abandoned _____

Date

APR 12 1950 19 _____ J. E. TYRA _____ Scout

Kansas

Wildcat

Map No. _____ Sec. 13 Twp. 27 R. 2EWell No. 1 Smith

_____ Eckland Drlg. _____ Company

_____ Contractor


C S L SE SE

E1.1320
SECTION PLAT

_____ Ft. from N. Line

330 Ft. from S. Line660 Ft. from E. Line

_____ Ft. from W. Line

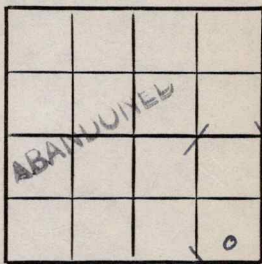

Sedgwick County

Location _____

Rig up _____

Drilling and Remarks:

8" C 105K.C. 2372T.D. 2486D + A

RECORD

Cased _____ in., _____ ft.

Sand _____

Gas _____

Oil _____

Total Depth 2486

PRODUCTION

1st 24 hrs. Nat. _____

1st 24 hrs. after shot _____

Gas _____ Cu. Ft.

Dry Hole _____

Abandoned _____

Date

APR 19 1950

19

J. E. TYRA

Scout