


Map No. _____ Sec. 29 Twp. 26 R. 6
Well No. 1 Wagoner (Wagner) Farm _____
Lewis Company _____

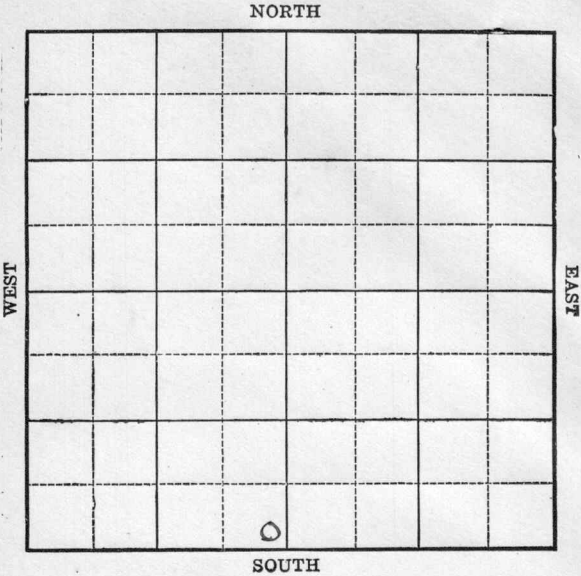

FIRST REPORT

Location _____

Drilling Remarks:

Rig up _____

Drilling Remarks:

RECORD


PRODUCTION

Cased _____ in. _____ ft.	1st 24 hrs Nat. _____
Sand _____	1st 24 hrs. after shot _____
Gas _____	Gas _____ cu. ft.
Oil _____	Dry Hole _____
Total Depth _____	Abandoned _____

Map No. _____ Sec. 29 Twp. 26 R. 6

Well No. 1 Wagoner Farm _____
Jenns Company _____

_____ Ft. from N. Line
200 Ft. from S. Line
200 Ft. from E. Line
_____ Ft. from W. Line

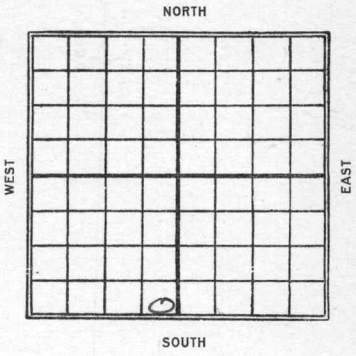

Date	REPORT
1923	
1/6	Timbers.
6/23	Sand 2762-71- At
	50 Bbls. Nat.

Map No. **Lewis** 14 29 Sec. 29 Twp. 26 R. 6Well No. *1 Wagoner**Lewis Oil* Company

Contractor

COMPLETED SECTION PLAT

_____Ft. from N. Line

200 _____Ft. from S. Line*200* _____Ft. from E. Line

_____Ft. from W. Line

Location _____

Rig up _____

Drilling and Remarks:

sand { 2762
2771
50 ft
nat

RECORD

Cased _____ in., _____ ft.

Sand _____

Gas _____

Oil _____

Total Depth _____

PRODUCTION

1st 24 hrs. Nat. _____

1st 24 hrs. after shot _____

Gas _____ Cu. Ft.

Dry Hole _____

Abandoned _____

Date

JUN 23 1923**M. A. BENEAR**

192

Scout

Map No. **KANSAS** ¹⁴ Sec. ²⁹ Twp. ²⁶ R. ⁶
 Well No. ¹ *Wagoner*
Lewis Company

Contractor

FIRST REPORT

SECTION PLAT

Ft. from N. Line

200 Ft. from S. Line*200* Ft. from E. Line

Ft. from W. Line

Location

Rig up

Drilling and Remarks:

Inters

RECORD

Cased _____ in., _____ ft.

Sand _____

Gas _____

Oil _____

Total Depth _____

PRODUCTION

1st 24 hrs. Nat. _____

1st 24 hrs. after shot _____

Gas _____ Cu. Ft.

Dry Hole _____

Abandoned _____

Date

JAN 6 1923

191

M. A. BENEAR

Scout