


Section 14 Township 27 Range 2EWell No. #6 HoultCompany J.P. Gaty

NORTH

WEST

EAST

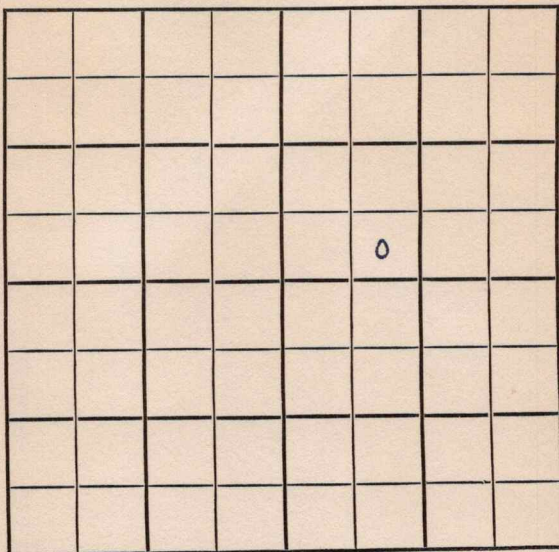

SOUTH

Sedgwick

KANSAS

SEC.	TWP.	R.
14	27	2E

WELL NO.

#6 Hoult

FARM

COMPANY

J.P. Gaty

CONTRACTOR

Morrison Drlg.

Minneha Pool

NORTH

Ft. from N. Line


160

Ft. from S. Line

Ft. from E. Line

1250

Ft. from W. Line

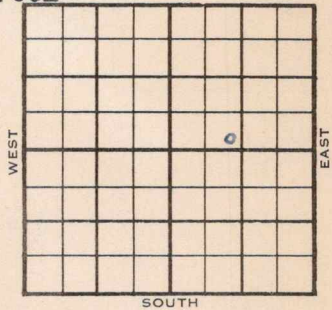

SE SW NE

SOUTH

	ELEVATION	REPORT
1954	1323'	
5/19	MIR	
	Spud 5-17-54	
7/21	Spud 5-17-54	
	Oil Well	
	TD 3252'	
	8" @ 54'	
	KC 2378', Marm. 2557', Miss 2838',	
	Kh. 3078', Hunton 3129', Viola 3142',	
	Simp. 3156', Arb. 3235'	
	TD 3238'	
	7" @ 3238'	
	DD 3252'	
	10X 10/3238-41	
	Comp. 25 bopd 10% wtr.	

COMPLETED

County Sedgwick State Kansas
 Sec. 14 (^{Blk.}27) (^{Sur.}2E) Map No. _____
 Operator J. P. Gaty
 Well No. 6 Farm Hoult
 Elev. 1323 Location SE SW NE

COMPLETE

160 Ft. From S Line NE
1250 Ft. From W Line Quarter
 1st. Report _____
 Completion JUL 21 1954
 Remarks Minneha Pool
Morrison Drlg. - Contr.
 Spudding Date 5-17-54

Drlg. Data Oil well TD 3252

8" @ 54 KC 2378 Marm. 2557

Miss. 2838 Kh. 3078 Hunton 3129

Viola 3142 Simp. 3156 Arb. 3235

TD 3238 7" @ 3238 DD 3252

10/ 3238-41 Comp. 25 bopd 10% wtr.