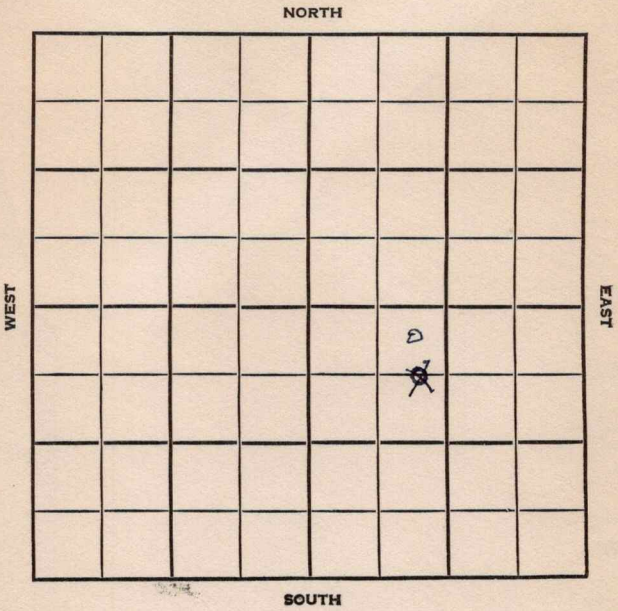


Section 14 Township 27 Range 2EWell No. 7 HoultCompany J. P. Gaty

Sedgwick

KANSAS

SEC.	TWP.	R.
14	27	2E ✓

WELL NO.

7 Hoult

FARM

COMPANY

J.P. Gaty

CONTRACTOR

Morrison Drlg-Contr.

330

~~660~~

Ft. from N. Line

Ft. from S. Line


Ft. from E. Line

840

~~1090~~

Ft. from W. Line

NE

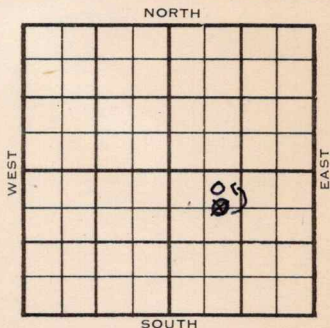~~0 E~~ NW SE

1954

ELEVATION

1333'

REPORT

6/2

Spud 5-29-54

8" @ 66

Drlg. 2365

6/30

Spud 5-29-54 D & A TD 3249

8" @ 66 KC 2389 Marm. 2571

Miss 2848 Kh. 3085 Hunton 3137

Viola 3152 Simp. 3165 Arb. 3242

TD 3245 7" @ 3245 DD 3249

250 A S/18 BFPH D & A

ABANDONED

County **Sedgwick** State **Kan.**Sec. **14** (Blk.) **27** (Sur.) **2E** Map No.Operator **J. P. Gaty**Well No. **7** Farm **Hoult**Elev. Location **C E $\frac{1}{2}$ NW SE**

FIRST REPORT

660 Ft. From **N** Line **SE****1090** Ft. From **W** Line Quarter1st. Report **JUN 2 1954**

Completion

Remarks

Morrison Drlg. - Contr.Spudding Date **5-29-54**

Drlg. Data

8" @ 66 drlg. 2365

J. G. McGEHEE

Kansas

Map No. _____ Sec. 14 Twp. 27 R. 2E

Well No. 7 Hoult

J. P. Gaty Company

CORRECTION

Contractor

NE NW SE


SECTION PLAT

330 Ft. from N. Line

_____ Ft. from S. Line

_____ Ft. from E. Line

840 Ft. from W. Line

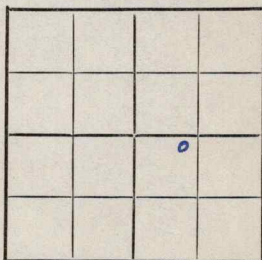

Sedgwick County

Location _____

Rig up _____

Drilling and Remarks:

Reported

C $E\frac{1}{2}$ NW SE

RECORD

Cased _____ in., _____ ft.

Sand _____

Gas _____

Oil _____

Total Depth _____

PRODUCTION

1st 24 hrs. Nat. _____

1st 24 hrs. after shot _____

Gas _____ Cu. Ft.

Dry Hole _____

Abandoned _____

Date

JUN

8 1954

19

J. G. McGEHEE

Scout

County Sedgwick State Kansas
 Sec. 14 (Blk.) 27 (Sur.) 2E Map No.
 Operator J. P. Gaty
 Well No. 7 Farm Hoult
 Elev. 1333 Location NE NW SE



330 Ft. From N Line SE
840 Ft. From W Line Quarter

1st. Report

Completion JUN 30 1954

Remarks

Morrison Drlg. - Contr.

Spudding Date 5-29-54

Drlg. Data D & A TD 3249

8" @ 66 KC 2389 Marm. 2571

Miss. 2848 Kh. 3085 Hunton 3137

Viola 3152 Simp. 3165 Arb. 3242

TD 3245 7" @ 3245 DD 3249 250 A

S/ 18 bfph

D & A