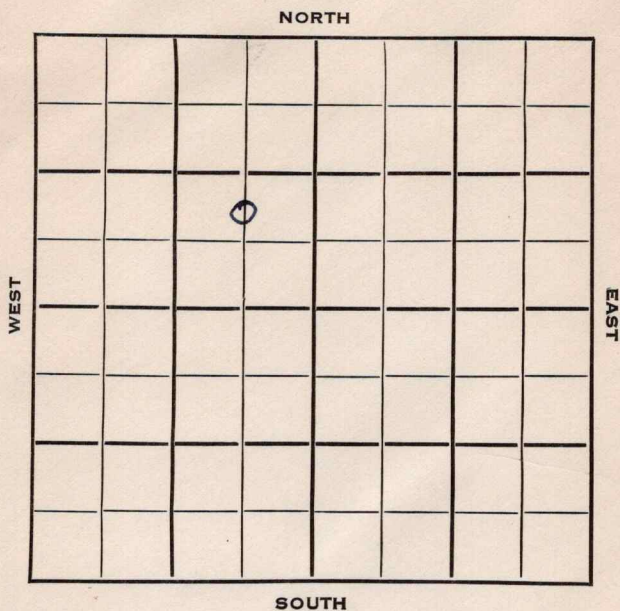


Section 14 Township 27 Range 2EWell No. 1 HoultCompany J. P. Gaty

Sedgwick

KANSAS ✓

SEC. 14	TWP. 27	R. 2 E
------------	------------	-----------

WELL NO.

1 Hoult

FARM

COMPANY

J. P. Gaty

CONTRACTOR

Morrison Drlg.

Kuske Pool

Ft. from N. Line

990


Ft. from S. Line

660

Ft. from E. Line

Ft. from W. Line

C N L SE NW

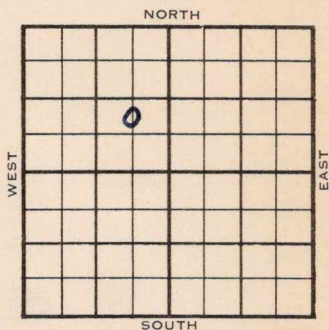

1953

ELEVATION

REPORT

9/16

8" @ 120

9/30

D & A

TD 3301'

8" @ 120'

KC 2418, Marm 2604, Miss 2881, Kh
3107, Hunton 3178, Viola 3190, Simp
3208, Arb 3293

TD 3301'

D & A

ABANDONED

County Sedgwick State Kansas
 Sec. 14 (Blk.) 27 (Sur.) 2E Map No.
 (Twp.)
 Operator J. P. Gaty
 Well No. 1 Farm Hoult
 Elev. _____ Location C N L SE NW

FIRST REPORT

990 Ft. From S Line NW
660 Ft. From E Line Quarter

1st. Report SEP 16 1953

Completion _____

Remarks _____

Morrison Drlg. - Contr.

Spudding Date _____

Drlg. Data Kuske Pool

8" @ 120

County Sedgwick State KansasSec. 14 (Blk. 27) (Sur. 2E) Map No. 2EOperator J. P. GatyWell No. 1 Farm HoultElev. Location C N L SE NW990 Ft. From S Line NW660 Ft. From E Line Quarter1st. ReportCompletion SEP 30 1953Remarks Kuske PoolMorrison Drlg. - Contr.Spudding DateDrlg. Data D & A TD 33018" @ 120 KC 2418 Marm. 2604Miss. 2881 Kh. 3107 Hunton 3178Viola 3190 Simp. 3208 Arb. 3293TD 3301D & A