


Section 14 Township 27 Range 2E
Well No. 2 Holt *(Holt)*
Company J. P. Gaty

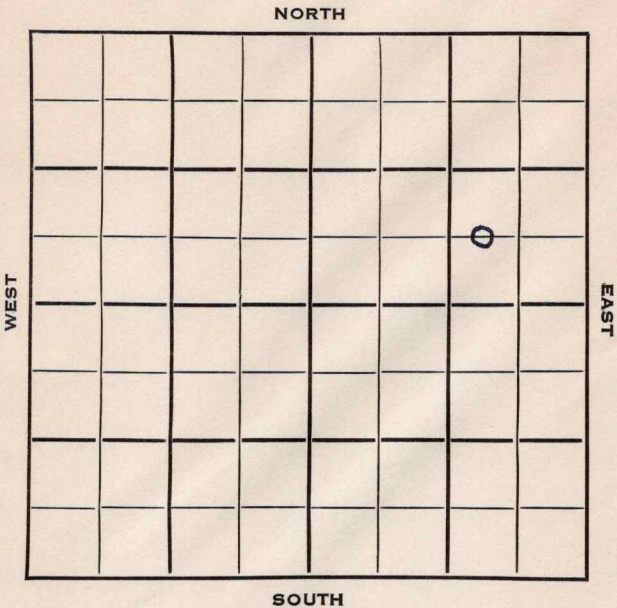

SEC.	TWP.	R.
14	27	2E ✓

WELL NO.

2 Holt

FARM

COMPANY

J. P. Gaty

CONTRACTOR

Morrison Drlg.
Eastborough Pool

Ft. from N. Line


660

Ft. from S. Line

990

Ft. from E. Line

Ft. from W. Line

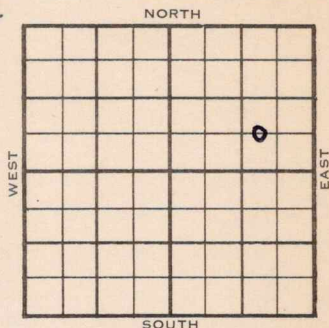

C W L SE NE

	ELEVATION	REPORT
1954	1326'	

2/10 Spud 2-4-54
Drlg. 2450'

3/10 Spud 2-4-54
Oil Well
TD 3235'
KC 2383', Marm 2562' Cong 2818'
Miss 2842', Kh. 3008', Hunton 3129'
Viola 3138', Simp dolo 3151', Simp
Sd 3158'
TD 3223'
5" @ 3223'
DD 3235'
S/ 25 bopd
Arb 3228'
Comp 25 bopd.

COMPLETED

County Sedgwick State Kansas
 Sec. 14 (Blk.) 27 (Sur.) 2E Map No.
 Operator J. P. Gaty
 Well No. 2 Farm Holt
 Elev. _____ Location C W L SE NE

FIRST REPORT

660 Ft. From S Line NE
990 Ft. From E Line Quarter
 1st. Report FEB 10 1954

Completion _____

Remarks _____

Morrison Drlg. - Contr.

Spudding Date 2-4-54

Drlg. Data _____

Eastborough Pool

drlg. 2450

J. G. McGEHEE

County Sedgwick State KansasSec. 14 (Blk. 27 (Sur. 2E (Twp. 2E Map No. Operator J. P. GatyWell No. 2 Farm HoltElev. 1326 Location C W L SE NE

660 Ft. From S Line NE990 Ft. From E Line Quarter1st. Report MAR 10 1954Completion Remarks Eastborough PoolMorrison Drlg. - Contr.Spudding Date 2-4-54Drlg. Data Oil well TD 3235KC 2383 Marm. 2562 Cong. 2818Miss. 2842 Kh. 3008 Hunton 3129Viola 3138 Simp. dol. 3151 Simp. sd.3158 TD 3223 5" @ 3223 DD 3235S/ 25 bopd Arb. 3228 Comp. 25 bopd

J. G. McGEHEE