


Map No. K14 Sec. 30 Twp. 26 R. 6

Well No. 2
Niagara Oil Company

Contractor

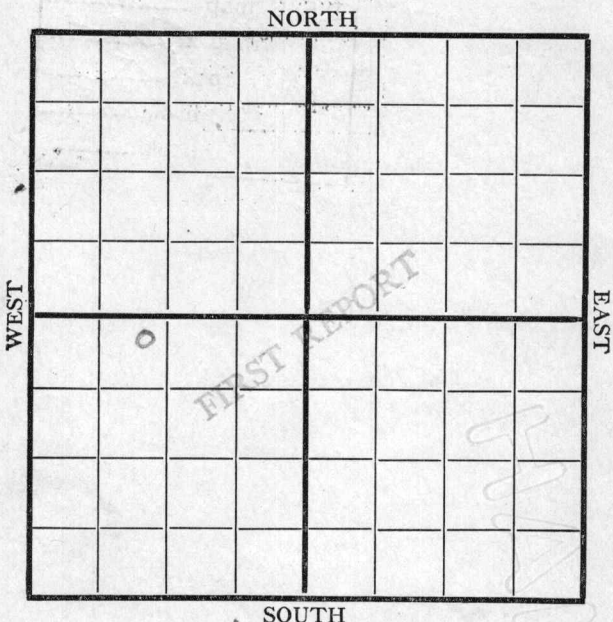

Location 250-N
1070-W

Rig up ✓

Drilling and Remarks:

RECORD

Cased _____ in., _____ ft.
 Sand _____
 Gas _____
 Oil _____
 Total Depth _____

PRODUCTION

1st 24 hrs. Nat. _____
 1st 24 hrs. after shot _____
 Gas _____ Cu. Ft.
 Dry Hole _____
 Abandoned _____

Date 10/8 1918 C. L. Scout


Map No. K14 Sec. 30 Twp. 26 R. 6Well No. 2 AngerNiagara Oil Company

Contractor

NORTH

WEST

EAST

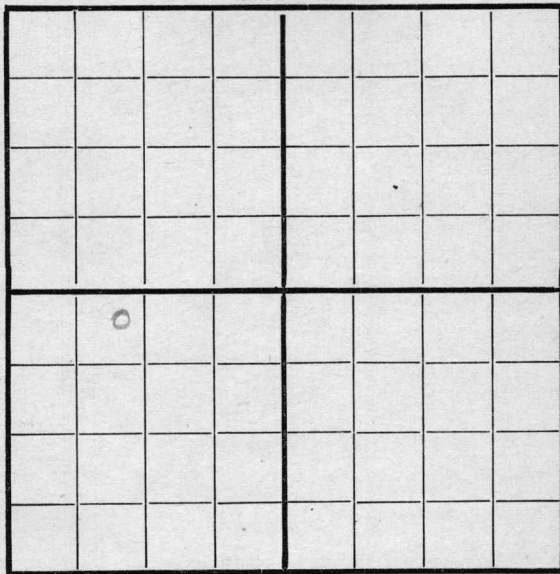

SOUTH

Location 250-NRig up 1070-W

Drilling and Remarks:

Spudding

RECORD

Cased _____ in., _____ ft.

Sand _____

Gas _____

Oil _____

Total Depth _____

PRODUCTION

1st 24 hrs. Nat. _____

1st 24 hrs. after shot _____

Gas _____ Cu. Ft.

Dry Hole _____

Abandoned _____

Date

10/17

191

8Pyle

Scout

Map No. K14 Sec. 30 Twp. 26 R. 6Well No. 2 GagerNiagara Oil Company

Contractor

NORTH

WEST

EAST

SOUTH

Location 250-NRig up 1070-W

Drilling and Remarks:

500'

RECORD

Cased _____ in., _____ ft.

Sand _____

Gas _____

Oil _____

Total Depth _____

PRODUCTION

1st 24 hrs. Nat. _____

1st 24 hrs. after shot _____

Gas _____ Cu. Ft.

Dry Hole _____

Abandoned _____

Date

10/123 191

Pyle

Scout

Map No. K15 Sec. 30 Twp. 26 R. 6Well No. 2Niagara Oils Company

Contractor

NORTH

WEST

EAST

SOUTH

Location 250-NRig up 1076-W

Drilling and Remarks:

fishing
@
860'

RECORD

Cased _____ in., _____ ft.

Sand _____

Gas _____

Oil _____

Total Depth _____

PRODUCTION

1st 24 hrs. Nat. _____

1st 24 hrs. after shot _____

Gas _____ Cu. Ft.

Dry Hole _____

Abandoned _____

Date

11/6 1918

Pyle

Scout


Map No. 1514 Sec. 30 Twp. 26 R. 6Well No. 2 Anger
Niagara O & G Company

Contractor

NORTH

WEST

EAST

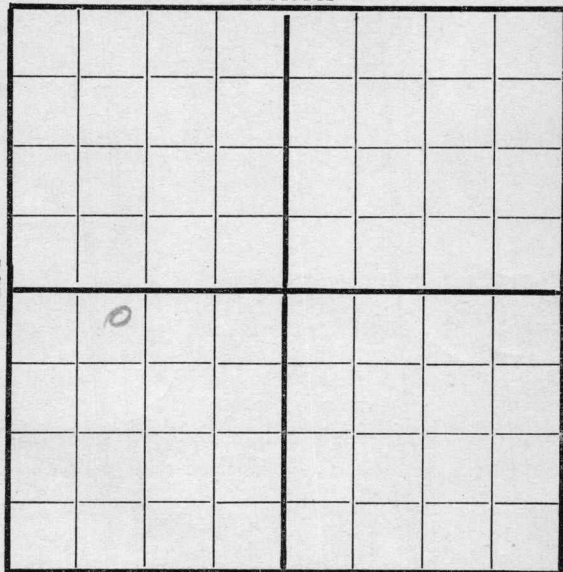

SOUTH

Location 250-NRig up 1070-W

Drilling and Remarks:

110 5'

RECORD

Cased _____ in., _____ ft.

Sand _____

Gas _____

Oil _____

Total Depth _____

PRODUCTION

1st 24 hrs. Nat. _____

1st 24 hrs. after shot _____

Gas _____ Cu. Ft.

Dry Hole _____

Abandoned _____

Date

11/13

1918

Pyle

Scout


Map No. 1514 Sec. 30 Twp. 26 R. 6Well No. 2 FingerNiagara O & G Company

Contractor

NORTH

WEST

EAST

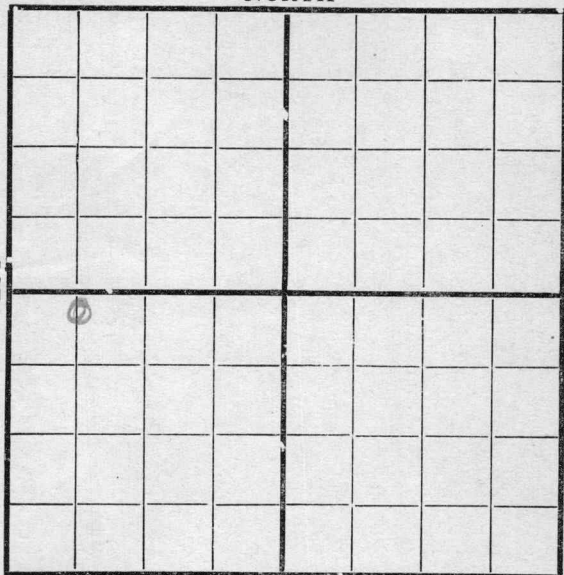250 - N

SOUTH

660 - W

Location _____

Rig up _____

Drilling and Remarks:

210 @
1200

RECORD

Cased _____ in., _____ ft.

Sand _____

Gas _____

Oil _____

Total Depth _____

PRODUCTION

1st 24 hrs. Nat. _____

1st 24 hrs. after shot _____

Gas _____ Cu. Ft.

Dry Hole _____

Abandoned _____

Date

11/19 1918 Pyke Scout


Map No. K14 Sec. 30 Twp. 26 R. 5Well No. 2Niagara Oil Company

Contractor

NORTH

WEST

EAST

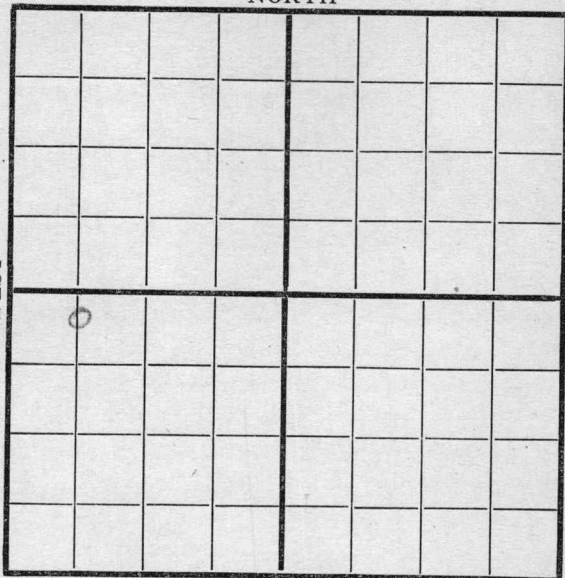

SOUTH

250-N660-W

Location _____

Rig up _____

Drilling and Remarks:

1800'

RECORD

Cased _____ in., _____ ft.

Sand _____

Gas _____

Oil _____

Total Depth _____

PRODUCTION

1st 24 hrs. Nat. _____

1st 24 hrs. after shot _____

Gas _____ Cu. Ft.

Dry Hole _____

Abandoned _____

Date

Pyle191

Scout

29

Map No. K14 Sec. 30 Twp. 26 R. 6Well No. 2 StripperNiagara Oil


Company

Contractor

NORTH

WEST

EAST

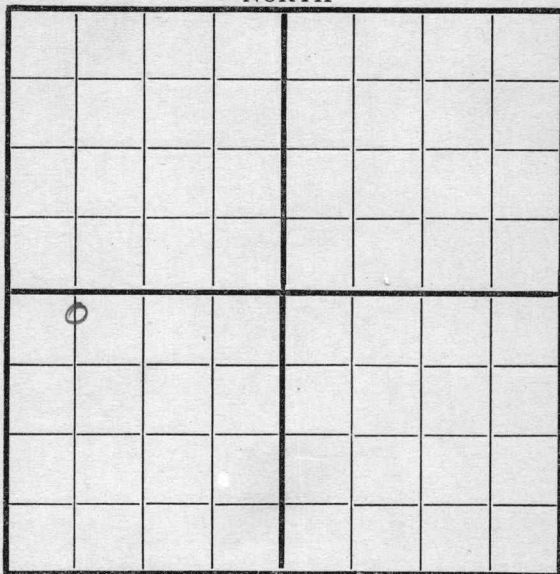250-N

SOUTH

660-W

Location _____

Rig up _____

Drilling and Remarks:

1940'

RECORD

Cased _____ in., _____ ft.

Sand _____

Gas _____

Oil _____

Total Depth _____

PRODUCTION

1st 24 hrs. Nat. _____

1st 24 hrs. after shot _____

Gas _____ Cu. Ft.

Dry Hole _____

Abandoned _____

Date

12/51918Pyle Scout


Map No. K14 Sec. 30 Twp. 26 R. 6Well No. 2 UngerMagnum O & G. Company

Contractor

NORTH

WEST

EAST

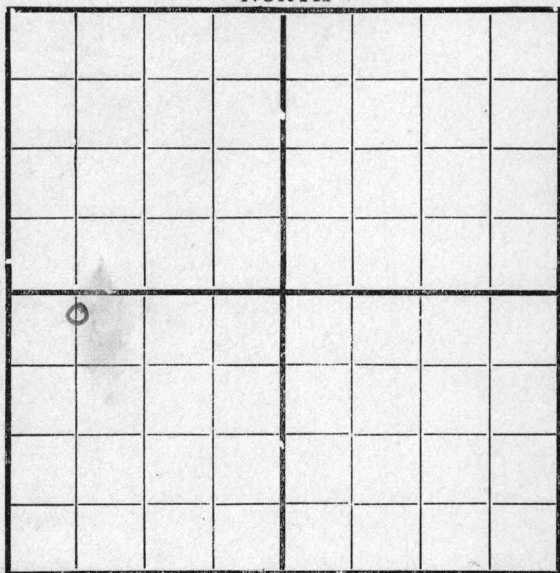

250 N SOUTH

660 W

Location _____

Rig up _____

Drilling and Remarks:

RECORD

Cased _____ in., _____ ft.

Sand _____

Gas _____

Oil _____

Total Depth _____

PRODUCTION

1st 24 hrs. Nat. _____

1st 24 hrs. after shot _____

Gas _____ Cu. Ft.

Dry Hole _____

Abandoned _____

Date

12/12 1918

H. B.

Scout


Map No. K14 Sec. 30 Twp. 26 R. 6Well No. 2 Unger
Niagara O & G. Company _____

Contractor _____

NORTH

WEST

EAST

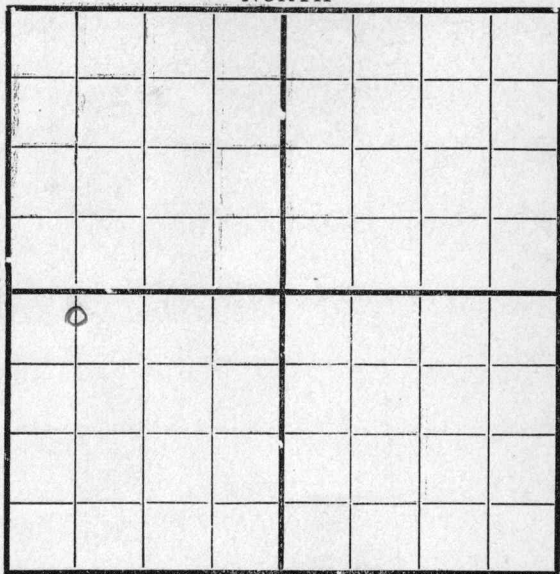

250-N

SOUTH

660-W

Location _____

Rig up _____

Drilling and Remarks:

2320'

RECORD

Cased _____ in., _____ ft.

Sand _____

Gas _____

Oil _____

Total Depth _____

PRODUCTION

1st 24 hrs. Nat. _____

1st 24 hrs. after shot _____

Gas _____ Cu. Ft.

Dry Hole _____

Abandoned _____

Date

12/18

191

8


Pyle

Scout

Map No. K14 Sec. 30 Twp. 26 R. 6Well No. 2 HugerNiagara O & G Company

Contractor

NORTH

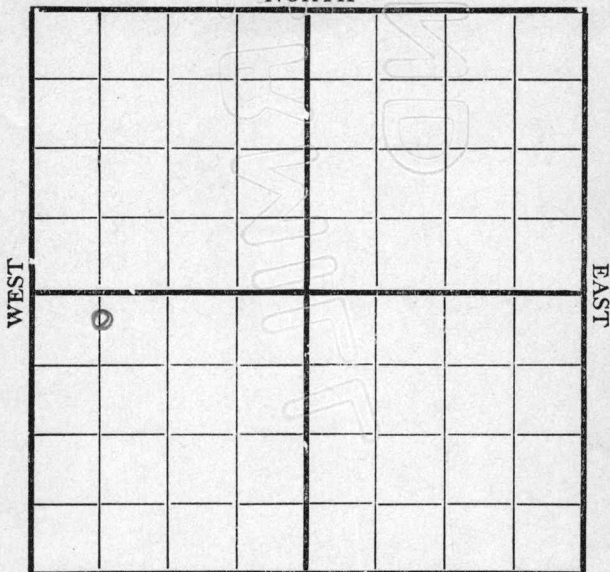

SOUTH

660 - W

250 N

Location _____

Rig up _____

Drilling and Remarks:

Top D. 2766
no oil

RECORD

Cased _____ in., _____ ft.

Sand _____

Gas _____

Oil _____

Total Depth _____

PRODUCTION

1st 24 hrs. Nat. _____

1st 24 hrs. after shot _____

Gas _____ Cu. Ft.

Dry Hole _____

Abandoned _____


Date

12/27 191 *8* **Pyle** Scout

Map No. K14 Sec. 30 Twp. 26 R. 6Well No. 2 26/30Niagara O & G Company

Contractor

NORTH

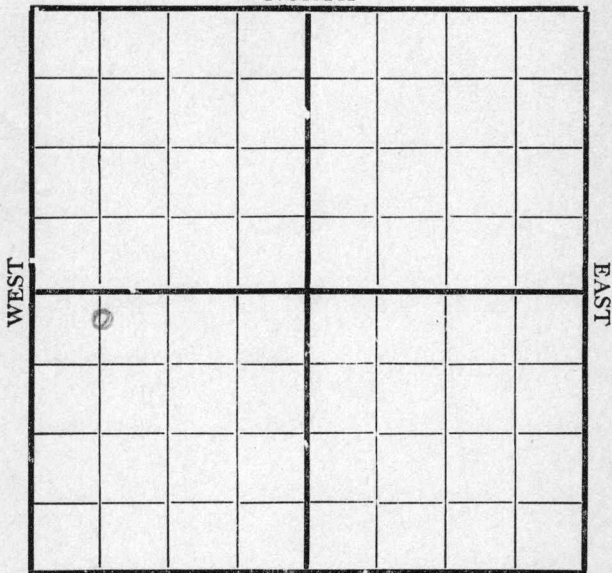

SOUTH

660-W250N

Location _____

Rig up _____

Drilling and Remarks:

RECORD

Cased _____ in., _____ ft.

Sand _____

Gas _____

Oil _____

Total Depth _____

PRODUCTION

1st 24 hrs. Nat. _____

1st 24 hrs. after shot _____

Gas _____ Cu. Ft.

Dry Hole _____

Abandoned _____

Date

Jan 16 1919

Pyle

Scout


Map No. K 14 Sec. 30 Twp. 26 R. 6Well No. 2 FingerNiagara O & G Company

Contractor

NORTH

WEST

EAST

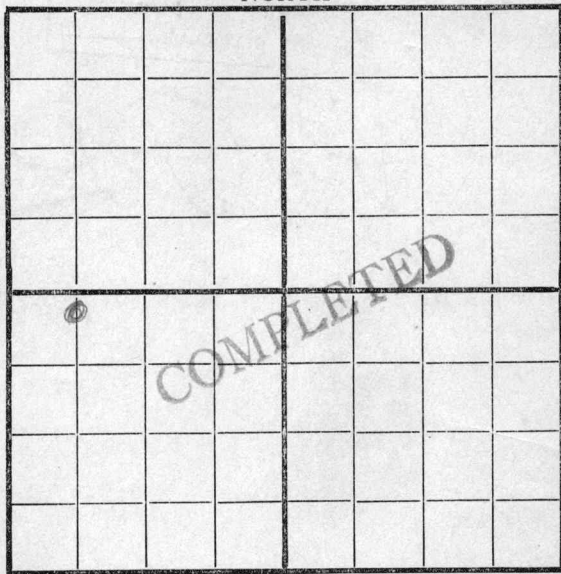

250' N

SOUTH

660 W

Location _____

Rig up _____

Drilling and Remarks:

This is correct

RECORD

Cased _____ in., _____ ft.

Sand 2749 - 2771

Gas _____

Oil _____

Total Depth _____

PRODUCTION

1st 24 hrs. Nat. 3.5 bbls

1st 24 hrs. after shot _____

Gas _____ Cu. Ft.

Dry Hole _____

Abandoned _____

Date

Feb 6 1919Pyle

Scout