
Form 51 SM 11-23 13896

Map No. K Sec. 32 Twp. 23 R. 10

Well No. 32 Thrall Farm

Missouri Ethal Company

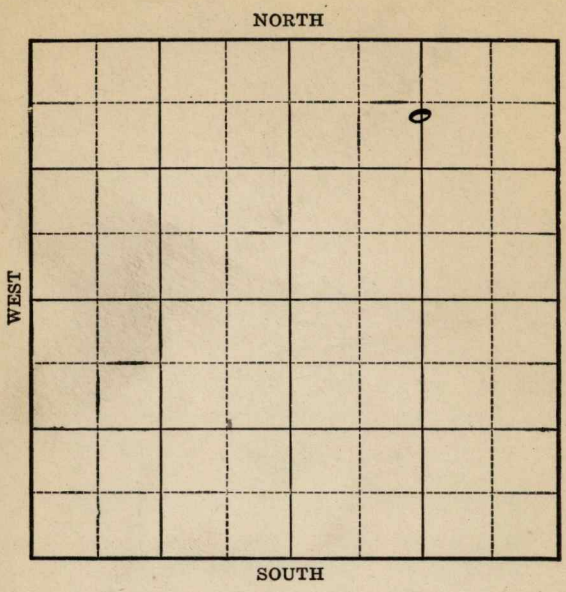


Location _____

Drilling Remarks:

Rig Up _____

Drilling Remarks:

RECORD

Cased _____ in. _____ ft.

Sand _____

Gas _____

Oil _____

Total Depth _____

PRODUCTION

1st 24 hrs. Nat. _____

1st 24 hrs. after shot _____

Gas _____ cu. ft.

Dry Hole _____

Abandoned _____

Form 252A 5M 4-22 8765

Map No. K Sec. 32 Twp. 23 R. 10

Well No. 32 Thrall Farm


Mission Ebal Company

760 Ft. from N. Line

_____ Ft. from S. Line

1320 Ft. from E. Line

_____ Ft. from W. Line

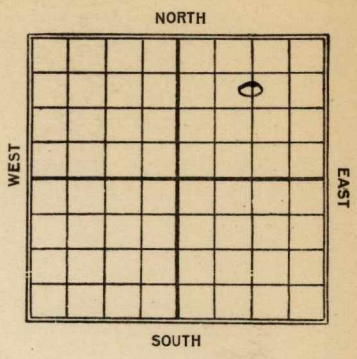


| Date | REPORT |
|---|---|
| ~~4/24~~ | |
| 2/27 | Rig up |
| 4/2 | Top Sand 2251- |
| | Perf - 2271-2306 |
| | Tbl. 2215' |
| | 140/150 Bbls |

Form 26—1M Bks.—3-23—11959.

Map No. 16 Sec. 32 Twp. 23 R. 10

Well No. 32 J. Hall

Mission Stat Company

Contractor

FIRST REPORT


760 Ft. from N. Line

Ft. from S. Line

1320 Ft. from E. Line

Ft. from W. Line

SECTION PLAT

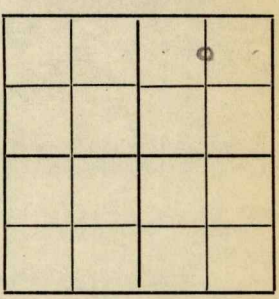

Location

Rig up

Drilling and Remarks:

RECORD

Cased in., ft.

Sand

Gas

Oil

Total Depth

PRODUCTION

1st 24 hrs. Nat.

1st 24 hrs. after shot

Gas Cu. Ft.

Dry Hole

Abandoned

Date

FEB 27 1924

192

M. A. BENEAR

Scout


Form 32 S.C.O.P.Co. 500 Bks. 5-23 12529

Map No. KANSAS Sec. 32 Twp. 23 R. 10

Well No. 32 J Shull Farm

Missouri Gas Company

760 from N NORTH 1320 from E.

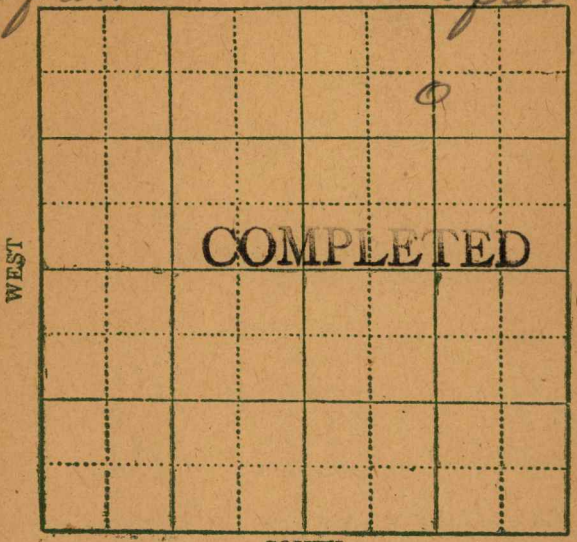


Location _____

Rig up _____

Drilling and Remarks:

Top S. 2251

Pay 2271-2306

TD 2315

140/150 Hole

**RECORD**

Cased ____ in., _____ ft.

Sand _____

Gas _____

Oil _____

Total Depth _____

**PRODUCTION**

1st 24 hrs. Nat. _____

1st 24 hrs. after shot _____

Gas _____ Cu. Ft.

Dry Hole _____

Abandoned _____

Date APR 2 1924

192____

M. A. BENEAR

_____ Scout