


Section 10 Township 21 Range 3E

Well No. #1 Mott

Company Branine & Goering

Winkler

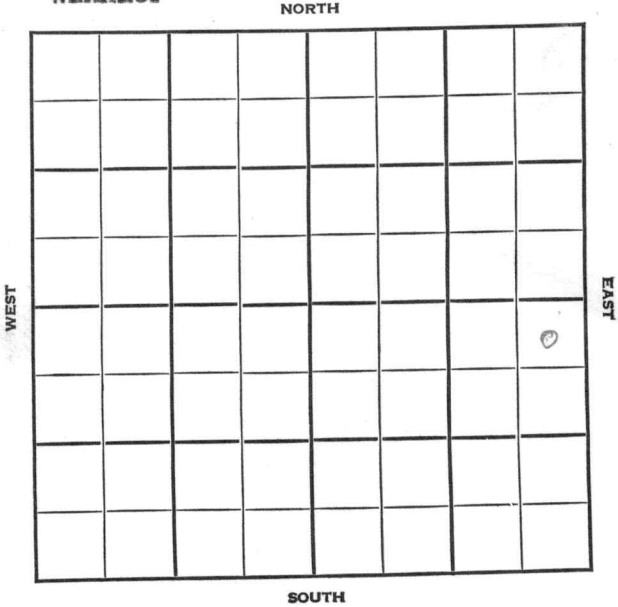

KANSAS

Marion

Sec. 10 Twp. 21 R. 3E

Well No. #1 Mott Farm

Branine & Goering Company

Winkler Pool


330' Ft. from N. Line

Ft. from S. Line

330' Ft. from E. Line

Ft. from W. Line

NE SE

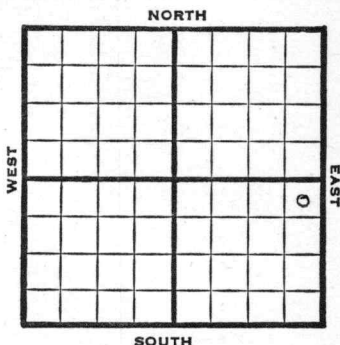

1947

Elev. 1387' REPORT

1/7 Location

1/14 Drlg 175'

1/21 8" @ 65'  
Drlg. 2129'

1/26 Lansing 1907'  
Mississippi 2514'  
B Miss. 2619'  
Hunton 2774-77'  
5" @ 2776'  
RUST

2/4 "

2/11 "

2/18 HFO

2/25 "

3/3 Hunton 2774'  
5" @ 2776'  
Pump 40 Pot.  
Gr. 380  
Total Depth 2777'  
**COMPLETED**

Map No. \_\_\_\_\_ Sec. 10 Twp. 21 R. 3E

Well No. 1 Mott

Branine & Goering Company

FIRST REPORT Contractor

NE SE

SECTION PLAT

330 Ft. from N. Line

\_\_\_\_\_ Ft. from S. Line

330 Ft. from E. Line

\_\_\_\_\_ Ft. from W. Line


Marion County

Location X

Rig up \_\_\_\_\_

Drilling and Remarks:

RECORD

Cased \_\_\_\_\_ in., \_\_\_\_\_ ft.

Sand \_\_\_\_\_

Gas \_\_\_\_\_

Oil \_\_\_\_\_

Total Depth \_\_\_\_\_

PRODUCTION

1st 24 hrs. Nat. \_\_\_\_\_

1st 24 hrs. after shot \_\_\_\_\_

Gas \_\_\_\_\_ Cu. Ft.

Dry Hole \_\_\_\_\_

Abandoned \_\_\_\_\_

Date

JAN 7 1948 19

S. J. LEWIS Scout

Map No. 24 Sec. 10 Twp. 21 R. 3E

Well No. 1 Mott

Branine & Goering Company

**COMPLETE**

Contractor

NE SE

*E 11387*  
**SECTION PLAT**

330 Ft. from N. Line

         Ft. from S. Line

330 Ft. from E. Line

         Ft. from W. Line

			o

Marion County

Location                                 

Rig up                                 

Drilling and Remarks:

*Hammer 2774*

*5" @ 2776*

*Pump 40 ft*

*35' @*

**RECORD**

Cased          in.,          ft.

Sand                                 

Gas                                 

Oil                                  ✓

Total Depth 2772

**PRODUCTION**

1st 24 hrs. Nat.                         

1st 24 hrs. after shot                         

Gas                                  Cu. Ft.

Dry Hole                                 

Abandoned                                 

Date

MAR 3 1948 19

S. J. LEWIS

Scout