


Map No. **KANSAS** Sec. 17 Twp. 27 R. 2¹⁵

Well No. 1- Rouns Farm

Nixon & Spencer Company

NORTH

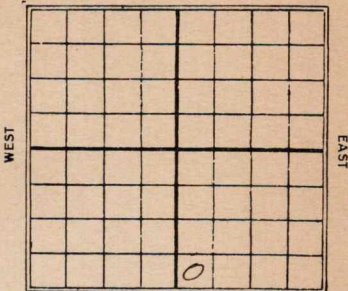

Ft. from N. Line

330 Ft. from S. Line

Ft. from E. Line

330 Ft. from W. Line

SOUTH

Date

REPORT

5/21	ROJ.
5/28	Rign up
6/4	Find tools 460'
6/11	hdlg. 1350'
6/18	" 2350'
6/25	" 2550'
7/2	6"- 2710
	S.D. 2825'
7/9	Shat 2960-62'
	74W T.D. 2964
	U/R. 6"
7/16	6"- 3005'
	hdlg. 3020'
7/23	Base Mississippi
	lime 3244'
	Top Viola 3298'
	74W 3312 hdlg.
7/30	T.D. 3403
	Dry & Abandon

*Geolquich*Map No. **KANSAS** Sec. *17* Twp. *27* R. *2E*Well No. *1 Round**Winn & Spencer* Company

Contractor

SECTION PLAT

Ft. from N. Line

330 Ft. from S. Line

Ft. from E. Line

330 Ft. from W. Line

FIRST REPORTS

Location

Rig up

Drilling and Remarks:

RECORD

Cased in., ft.

Sand

Gas

Oil

Total Depth

PRODUCTION

1st 24 hrs. Nat.

1st 24 hrs. after shot

Gas Cu. Ft.

Dry Hole

Abandoned

Date

MAY 21 1930

192

S. J. LEWIS

Scout

Map No. **KANSAS** Sec. 17 Twp. 27 R. 2E

Well No. 1 Round

Wixon & Spencer Company

Contractor

SECTION PLAT

_____ Ft. from N. Line

830 Ft. from S. Line

_____ Ft. from E. Line

830 Ft. from W. Line

ABANDONED

Location _____

Rig up _____

Drilling and Remarks:

RECORD

Cased _____ in., _____ ft.

Sand _____

Gas _____

Oil _____

Total Depth 8703

PRODUCTION

1st 24 hrs. Nat. _____

1st 24 hrs. after shot _____

Gas _____ Cu. Ft.

Dry Hole _____

Abandoned _____

Date

JUL 30 1930 19

S. J. LEWIS

Scout