


Kingman

AS

SECTION 22 TOWNSHIP 29S RANGE 7W

WELL NO. #1 Pierce

COMPANY Thomas H. Allan

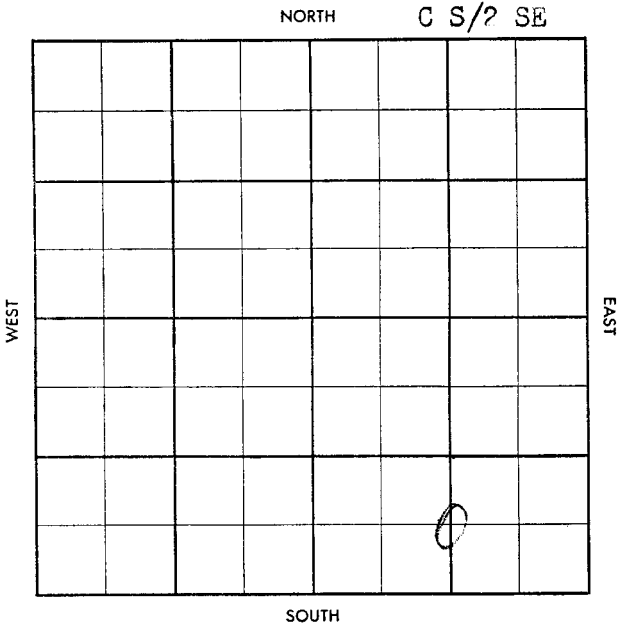

~~Trenton~~

S-513-A

CO. <u>Kingman</u>		ELEV. _____	CO. JAN 2 58 FIRST REPORT																			
SEC. <u>22</u>	TWP. <u>29</u>	RGE. <u>7W</u>																				
COMPANY <u>Thomas H. Allam</u>		NO. <u>1</u>																				
FARM <u>Pierce</u>		S.W.D.W. _____	LSE																			
LOC. <u>C S/2 SE/4</u>																						
<table border="1"><tr><td></td><td></td></tr><tr><td></td><td></td></tr><tr><td></td><td></td></tr><tr><td></td><td></td></tr><tr><td></td><td></td></tr><tr><td></td><td></td></tr><tr><td></td><td></td></tr><tr><td></td><td></td></tr><tr><td></td><td></td></tr><tr><td></td><td></td></tr></table>																					GEOL. _____	NO. SEC. TWP. RGE.
CONTR. <u>Co. Tools</u>																						
POOL <u>Trenton</u>																						
SPUD <u>12/27/57</u>																						
<u>setting surface.</u>																						

~~K-27~~

~~Trenton~~

S-513-A

CO. ~~Kingman~~ ELEV. _____
SEC. 22 TWP. 29 RGE. 7W
COMPANY Thomas H. Allam NO. 1

ABANDONED

JAN 8 '58

FARM Pierce S.W.D.W.

LOC. C S/2 SE/4

GEOL. _____

CONTR. Co. Tools

POOL Trenton

SPUD 12/27/57

setting surface.

JAN 8 '58 8" 1480/400

~~2140~~ TD

15) input 18

Bu ph in

Ft Riley

TD 2140

S.W.D.W.