


DX 78-1 Butler

Section 32 Township 26S Range 5E

Well No. ^{"A"}#1 D. W. Hill - West

Company Henry Inger

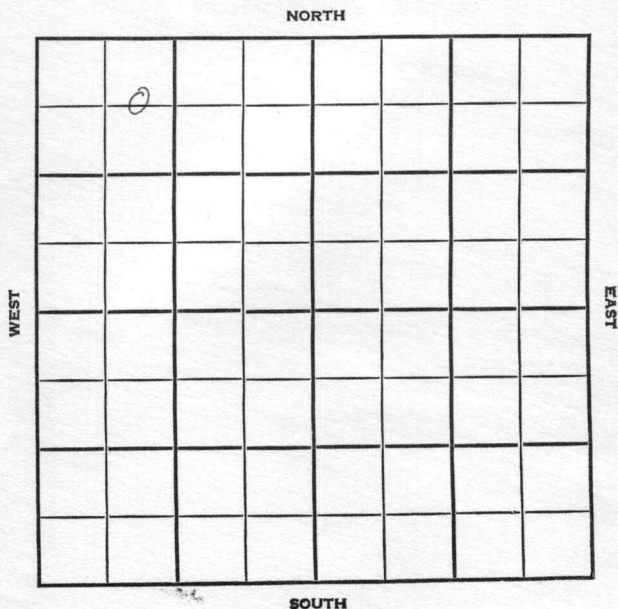

SEC. 32 TWP. 26 R. 5E

WELL NO. #1 "A" #1 D.W. Hill - West FARM

COMPANY Henry Inger

CONTRACTOR White & Ellis


Eldorado

500 FT. FROM N. LINE

FT. FROM S. LINE

FT. FROM E. LINE

1200 FT. FROM W. LINE

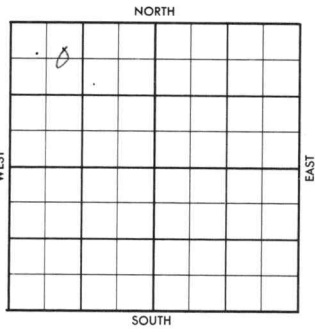

E 1/2 NW NW

1956 ELEVATION REPORT

7-25 Location

ABANDONED

County Butler Elev. _____
 Sec. 32 Twp. 26S Rgs. 5E
 Company Henry Inger
 Farm Name D. W. Hill No. 1

TOPS	DEPTH	LOG	DATUM
Anh.			
Tp.			
H.			
Tr.			
Dg.			
Bl.			
L.			
K.C.			
B.K.C.			
Ce.			
C.			
M.			
M.			
K.			
Mz.			
Ma.			
V.			
S.			
S.			
A.			
R.			
Pe.			
G.			
TD.			

Loc. in Sec. E/2 NW NW

Geol. _____
 Contr. Rig #3
White & Ellis
 Pool _____
Eldorado

o		
JUL 25	1956	
FIRST REPORT		

Date Comm. Loc.

29

Co.

Loc.

No.

Sec.

T.

R.

CORRECTION

FORM 513 SUNRAY

County Butler Elev. 1320 Co. 2
 Sec. 32 Twp. 26S Rge. 5E
 Company Henry Inger
 Farm Name D. W. Hill - WEST No. 14 - "A"

TOPS	DEPTH	LOG	DATUM	Loc. in Sec.
Anh.				E/2 NW NW
Tp.				
H.				500 NL
Tr.				1200 WL
Dg.				
Bl.				
L.	1759			
K.C.	2057			Geol.
B.K.C.				Contr. Rig #3
Ce.				White & Ell
C.				
M.	2530			Pool
M.				Eldorado
K.				
Mz.				
Mo.				
V.	2632			<div style="border: 1px dashed black; padding: 5px; width: fit-content; margin: auto;"> </div>
S.	2649	3649		
S.				
A.				
R.				
PE.				
G.				
TD.	2650	3650		

Date Comm. Loc. AUG 1 '56 7-28-54
10* 140 @ 1087
AUG 8 '56 7" @ 2649 AUG 15 '56 CD
AUG 22 '56 DD 2655 PB 2640
AUG 29 '56 SEP 5 '56 SEP 12 '56 7" @ 2649
DD 2655 (550) PB ? 48/
2631-43 @ 8 GO 12 1/2 POP
P. 5 Boph 24 hrs CS9
collapsed @ 1800
D&A